

MISSISSIPPI DEPARTMENT OF NATURAL RESOURCES

Bureau of Land and Water Resources

Southport Mall

P.O. Box 10631

Jackson, Mississippi 39209

WATER WELL DRILLERS LOG

S 44  
Sunflower  
9-16-83

CODED

Sept 16 1983  
date well completed

Lavis well & pump  
firm name

Sunflower  
county/well located

LANDOWNER: Paindexter Brothers

description of formations encountered

from

to

Inverness, Mo.  
(mailing address)

clay	0	30
sand	30	50
Sand & gravel	50	105

WELL LOCATION:

sec. 3 T 17 N R E  
S W  
1 miles WEST of Inverness  
(distance) (direction) (nearest town)

WELL PURPOSE:

(home, irrigation, municipal, industrial)

WELL COMPLETION DATA:

- (1) diameter (inches) 12"
- (2) total depth (feet) 105'
- (3) static water level (feet) 22 below top of ground.
- (4) casing Steel, 65' (material) (depth)  
(size) if telescope see back.
- (5) screen 40', 65' (length) (depth to top)  
12" Steel (size) (material)
- (6) pump 60 (HP) 1100 (yield gpm)  
(type power)
- (7) electric log NO (yes or no)  
(organization running log)

(8) how well bottom plugged Steel Plate

DRILLERS REMARKS:


DEPT. OF NATURAL RESOURCES  
BUREAU OF LAND & WATER RESOURCES

APR 2 1984

RECEIVED

If well telescopes please sketch and show depths.

GROUND LEVEL

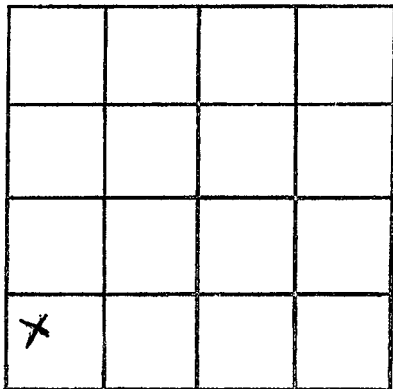

SECTION 3

Please indicate well location X.

ADDITIONAL INFORMATION

If more than one screen, show locations of each on sketch.