

MISSISSIPPI DEPARTMENT OF NATURAL RESOURCES  
Bureau of Land and Water Resources

Southport Mall  
P.O. Box 10631

Jackson, Mississippi 39209

WATER WELL DRILLERS LOG

BUTANE GAS COMPANY

OF GREENWOOD

*Sunflower*  
county well located

S45  
Sunflower  
3-16-84

CODED

3-16 1984  
date well completed

LANDOWNER: #3  
Martin Meyer  
A Kinlock  
Mr  
(mailing address)

description of formations encountered	from	to
<u>Clay</u>	<u>0</u>	<u>15</u>
<u>sand</u>	<u>15</u>	<u>65</u>
<u>sand &amp; gravel</u>	<u>65</u>	<u>105</u>

WELL LOCATION:  
sec. 21 T. 17 N. R. 5 E.  
S. (W)  
3/4 miles SW of Kinlock  
(distance) (direction) (nearest town)

WELL PURPOSE: irrigation  
(home, irrigation, municipal, industrial)

- WELL COMPLETION DATA:
- (1) diameter (inches) 16"
  - (2) total depth (feet) 105
  - (3) static water level (feet) 30 <sup>below</sup> above top of ground.
  - (4) casing Steel, 65'  
(material) (depth)
  - 16" if telescope see back.  
(size)
  - (5) screen 40', 65'  
(length) (depth to top)
  - 16", Steel  
(size) (material)
  - (6) pump 60, 1100  
(HP) (yield gpm)
  - Diesel  
(type power)
  - (7) electric log NO  
(yes or no)
  - NO  
(organization running log)
  - (8) how well bottom plugged steel plate

DEPT. OF NATURAL RESOURCES  
BUREAU OF LAND & WATER RESOURCES


MAR 20 1984

RECEIVED

DRILLERS REMARKS:  
Richard Vest

If well telescopes please sketch and show depths.

GROUND LEVEL

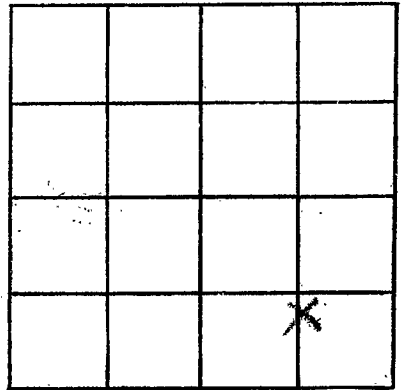

SECTION 21

Please indicate well location X.

ADDITIONAL INFORMATION

If more than one screen,  
show locations of each on sketch.