

MISSISSIPPI DEPARTMENT OF NATURAL RESOURCES

Bureau of Land and Water Resources

Southport Mall

P.O. Box 10631

Jackson, Mississippi 39209

WATER WELL DRILLERS LOG

S46
Sunflower Co.
3-3-84

CODED

3-3 1984
date well completed

BUTANE GAS COMPANY
OF GREENWOOD

Sunflower
county well located

LANDOWNER:	description of formations encountered	from	to
<i>Martin Myers</i>	<i>Clay</i>	0	20
<i>Kimberly No.</i>	<i>Sand</i>	20	40
(mailing address)	<i>Sand & Gravel</i>	40	95
WELL LOCATION:			
sec. <u>28</u> T. <u>17</u> N. R. <u>5</u> E. S. <u>W</u>			
<u>1.4</u> miles <u>SW</u> of <u>Kimberly</u> (distance) (direction) (nearest town)			
WELL PURPOSE: <u>Irrigation</u> (home, irrigation, municipal, industrial)			
WELL COMPLETION DATA:			
(1) diameter (inches) <u>16"</u>			
(2) total depth (feet) <u>95</u>			
(3) static water level (feet) <u>31</u> <u>below</u> above top of ground.			
(4) casing <u>Steel</u> , <u>55</u> (material) (depth)			
<u>16"</u> if telescope see back. (size)			
(5) screen <u>40'</u> , <u>55</u> (length) (depth to top)			
<u>16"</u> , <u>Steel</u> (size) (material)			
(6) pump <u>60</u> <u>1100</u> (HP) (yield gpm)			
<u>Diesel</u> (type power)			
(7) electric log <u>No</u> (yes or no)			
<u>No</u> (organization running log)			
(8) how well, bottom plugged <u>Steel plate</u>			
DRILLERS REMARKS:			
<u>Carlos Rhoads</u>			


DEPT. OF NATURAL RESOURCES
BUREAU OF LAND & WATER RESOURCES

MAR 20 1984

RECEIVED

If well telescopes please sketch and show depths.

GROUND LEVEL

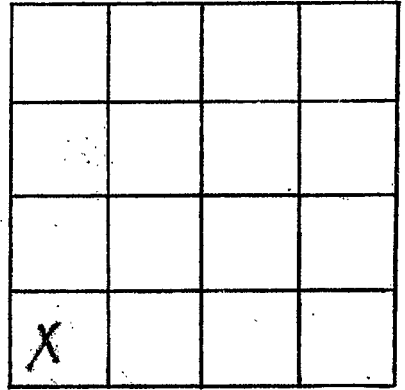

SECTION 28

Please indicate well location X.

ADDITIONAL INFORMATION

If more than one screen,
show locations of each on sketch.