

MISSISSIPPI DEPARTMENT OF NATURAL RESOURCES

Bureau of Land and Water Resources

Southport Mall

P.O. Box 10631

Jackson, Mississippi 39209

WATER WELL DRILLERS LOG

BUTANE GAS COMPANY

OF GREENWOOD
firm name

Sunflower
county well located

547
Sunflower Co
2-25-84

2-25 1984
date well completed

LANDOWNER: #1
Martin Myers
~~Padgett~~ Ms.
(mailing address)

description of formations encountered	from	to
CLAY	0	45
SAND & GRAVEL	45	105

WELL LOCATION:
sec. 32 T. 12 N. R. 5 E. S. 1 W.
2 miles SW. of Kinkadee
(distance) (direction) (nearest town)

WELL PURPOSE: FIRMIC
(home, irrigation, municipal, industrial)

- WELL COMPLETION DATA:
- (1) diameter (inches) 16"
 - (2) total depth (feet) 105'
 - (3) static water level (feet) 30 ^{below} above top of ground.
 - (4) casing steel, 65' (material), (depth)
16" (size) if telescope see back.
 - (5) screen 40 65' (length), (depth to top)
16" (size), steel (material)
 - (6) pump 60 1100 (HP), (yield gpm)
Pascal (type power)
 - (7) electric log No (yes or no)
No (organization running log)
 - (8) how well bottom plugged
Steel plate

DEPT. OF NATURAL RESOURCES
BUREAU OF LAND & WATER RESOURCES


MAR 20 1984

RECEIVED

DRILLERS REMARKS:
CARLOS RAMOS

If well telescopes please sketch and show depths.

GROUND LEVEL

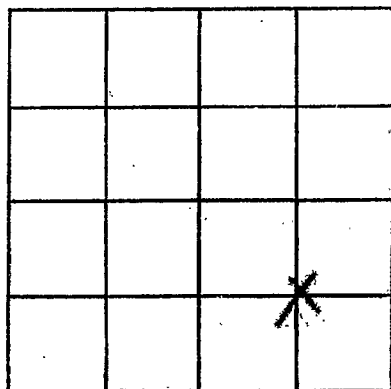

SECTION 32

Please indicate well location X.

ADDITIONAL INFORMATION

If more than one screen,
show locations of each on sketch.