

MISSISSIPPI DEPARTMENT OF NATURAL RESOURCES
Bureau of Land and Water Resources

Southport Mall
P.O. Box 10631

Jackson, Mississippi 39209
WATER WELL DRILLERS LOG

S48
Sunflower
3-24-84

CODED

BUTANE GAS COMPANY
OF GREENWOOD

Sunflower
county well located

8-24 1984
date well completed

LANDOWNER:
Kinloch Plantation
Martin Mays
(mailing address)

description of formations encountered

from	to
0	40
40	60
60	105

Clay
Sand
gravel

WELL LOCATION:
sec. 20 T 17 N R 5 E S 4
1.5 miles W of Kinloch
(distance) (direction) (nearest town)

CODED

WELL PURPOSE:
(home, irrigation, municipal, industrial)

WELL COMPLETION DATA:

(1) diameter (inches) 16"

(2) total depth (feet) 105'

(3) static water level (feet) 30 below above top of ground.

(4) casing Steel, 65' (material) (depth)
16" (size) if telescope see back.

(5) screen 40, 65' (length) (depth to top)
16", steel (size) (material)

(6) pump 150, 1400 (HP) (yield gpm)
Diesel (type power)

(7) electric log No (yes or no)
No (organization running log)

DEPT. OF NATURAL RESOURCES
BUREAU OF LAND & WATER RESOURCES

APR 23 1984


RECEIVED

(8) how well bottom plugged
Steel plate

DRILLERS REMARKS:
Charles Ramos

If well telescopes please sketch and show depths.

GROUND LEVEL

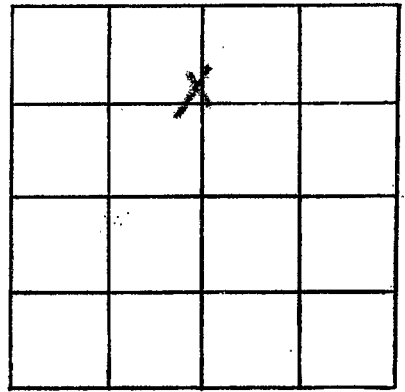

SECTION 20

Please indicate well location X.

ADDITIONAL INFORMATION

Lined area for additional information.

If more than one screen, show locations of each on sketch.