

MISSISSIPPI DEPARTMENT OF NATURAL RESOURCES

Bureau of Land and Water Resources

Southport Mall

P.O. Box 10631

Jackson, Mississippi 39209

WATER WELL DRILLERS LOG

BUTANE GAS COMPANY

OF GREENWOOD

*Sunflower*  
county well located

S50  
Sunflower Co  
4-4-84

CODED

4-4  
date well completed

19 84

LANDOWNER:	description of formations encountered	from	to
<i>Martin Myers</i>	CLAY	0	25
<i>Walter Cain</i>	SAND	25	55
#2 (mailing address)	Gravel	55	105
WELL LOCATION:			
sec. <u>20</u> T. <u>17</u> N. R. <u>5</u> E. <u>W</u>			
<u>1.44</u> miles <u>W</u> of <u>Kendrick</u>			
(distance) (direction) (nearest town)			
WELL PURPOSE: (home, irrigation, municipal, industrial)			
WELL COMPLETION DATA:			
(1) diameter (inches) <u>16"</u>			
(2) total depth (feet) <u>105</u>			
(3) static water level (feet) <u>30</u> <u>below</u> above top of ground.			
(4) casing <u>Steel</u> , <u>65'</u> (material), (depth)			
<u>16"</u> (size) if telescope see back.			
(5) screen <u>40'</u> , <u>65'</u> (length), (depth to top)			
<u>16"</u> , <u>Steel</u> (size), (material)			
(6) pump <u>150</u> (HP), <u>1100</u> (yield gpm)			
<u>Diesel</u> (type power)			
(7) electric log <u>NO</u> (yes or no)			
<u>No</u> (organization running log)			
(8) how well bottom plugged <u>steel plate</u>			
DRILLERS REMARKS:			
<u>Richard Vest m.</u>			

CODED


DEPT. OF NATURAL RESOURCES  
BUREAU OF LAND & WATER RESOURCES

APR 23 1984

RECEIVED

If well telescopes please sketch and show depths.

GROUND LEVEL

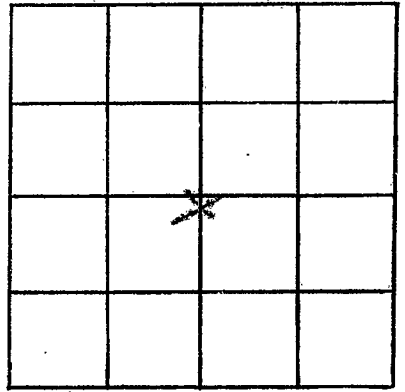

SECTION 20

Please indicate well location X.

ADDITIONAL INFORMATION

If more than one screen,  
show locations of each on sketch.