

MISSISSIPPI DEPARTMENT OF NATURAL RESOURCES

Bureau of Land and Water Resources

Southport Mall

P.O. Box 10631

CODED

Jackson, Mississippi 39209

WATER WELL DRILLERS LOG

551
Sunflower
5-21-84

BUTANE GAS COMPANY

Sunflower
county well located

5-21 1984
date well completed

OF GREENWOOD

LANDOWNER:
Walter Chin
Indianola
(mailing address)

description of formations encountered	from	to
	CLAY	0
Fine sand	30	55
Sand gravel	55	105

WELL LOCATION:
sec. 29 T 17 N R 5 E
S 4
2.5 miles SW of Kimberly
(distance) (direction) (nearest town)

WELL PURPOSE: Drain
(home, irrigation, municipal, industrial)

- WELL COMPLETION DATA:
- (1) diameter (inches) 16"
 - (2) total depth (feet) 105
 - (3) static water level (feet) 22 below above top of ground.
 - (4) casing Steel, 65'
(material) (depth)
16" if telescope see back.
(size)
 - (5) screen 40, 65'
(length) (depth to top)
16, Steel
(size) (material)
 - (6) pump 150 1400
(HP) (yield gpm)
Diesel
(type power)
 - (7) electric log NO
(yes or no)
NO
(organization running log)
 - (8) how well bottom plugged Steel plate

DRILLERS REMARKS:
Richard Vest Jr.


DEPT. OF NATURAL RESOURCES
BUREAU OF LAND & WATER RESOURCES

JUN - 4 1984

RECEIVED

If well telescopes please sketch and show depths.

GROUND LEVEL

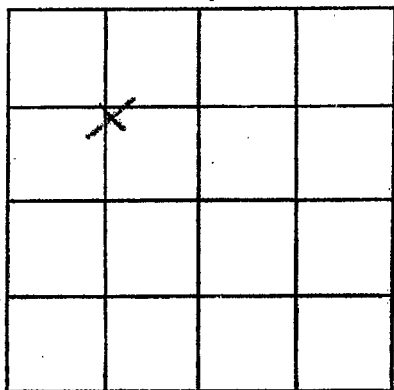

SECTION 29

Please indicate well location X.

ADDITIONAL INFORMATION

If more than one screen,
show locations of each on sketch.