

MISSISSIPPI DEPARTMENT OF NATURAL RESOURCES

Bureau of Land and Water Resources

Southport Mall

P.O. Box 10631

Jackson, Mississippi 39209

WATER WELL DRILLERS LOG

CODED

SUNFLOWER  
853

4-26 1984 date well completed  
Larry's Well Pump firm name  
Sunflower county well located

LANDOWNER: V.E. Lester

description of formations encountered

from to

Shiveness (mailing address)

Clay	0	30
Fine Sand	30	50
Coarse Sand & gravel	50	123

WELL LOCATION:

sec 26 T 17 N R 5 E  
S S W  
5 miles WEST of Isola  
(distance) (direction) (nearest town)

CODED

WELL PURPOSE:

(home, irrigation, municipal, industrial)

WELL COMPLETION DATA:

- (1) diameter (inches) 16"
- (2) total depth (feet) 123'
- (3) static water level (feet) 25' below top of ground.
- (4) casing Steel, 83' (material) (depth)
- (size) If telescope see back.
- (5) screen 60' 83' (length) (depth to top)
- 16" Steel (size) (material)
- (6) pump 60 3000 (HP) (yield gpm)
- D (type power)
- (7) electric log No (yes or no)

(organization running log)

- (8) how well bottom plugged Steel Plate

DRILLERS REMARKS:


DEPT. OF NATURAL RESOURCES  
BUREAU OF LAND & WATER RESOURCES

OCT 12 1984

RECEIVED

If well telescopes please sketch and show depths.

GROUND LEVEL

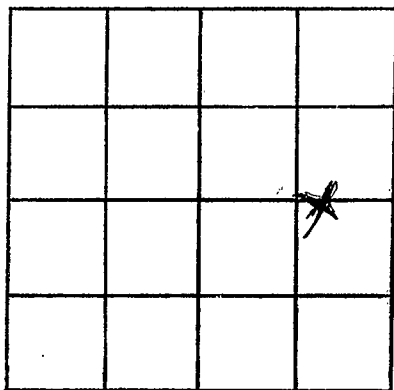

SECTION 26

Please indicate well location X.

ADDITIONAL INFORMATION

If more than one screen,  
show locations of each on sketch.