

MISSISSIPPI DEPARTMENT OF NATURAL RESOURCES
 Bureau of Land and Water Resources
 Southport Mall
 P.O. Box 10631
 Jackson, Mississippi 39209
WATER WELL DRILLERS LOG

CODED

Sunflower
S.B.S
7-11-85

7-11-85 19 IRRIGATION EQUIPMENT INC. SUNFLOWER
 date well completed firm name county well located

LANDOWNER: Sunflower County
BOARD of Education BOX 70
INDIANOLA, MS 38751
 (Fred Jones) (mailing address)

description of formations encountered	from	to
CLAY	0	15
FINE SAND	15	55
COURSE SAND / PEA GRAVEL	55	105

WELL LOCATION:
 sec. 16 T. 17 N. R. 5 E. S. 10 W.
10 miles S. west of INDIANOLA
 (distance) (direction) (nearest town)

CODED

WELL PURPOSE: PIVOT
 (home, irrigation, municipal, industrial)

- WELL COMPLETION DATA:
- diameter (inches) 16"
 - total depth (feet) 105'
 - static water level (feet) 19 below above top of ground.
 - casing steel (material), (depth), (size) if telescope see back.
 - screen 40 (length), 65' (depth to top), 16" (size), steel (material)
 - pump (HP), (yield gpm), (type power)
 - electric log NO (yes or no), (organization running log)
 - how well bottom plugged steel plate

RECEIVED

JUL 24 1985


Department of Natural Resources
 Bureau of Land & Water Resources

DRILLERS REMARKS:

If well telescopes please sketch and show depths.

REGISTRATION EQUIPMENT
11/887-2555
MOBILE, MS

GROUND LEVEL

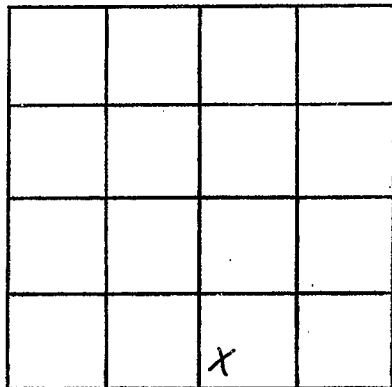

SECTION 16

Please indicate well location X.

ADDITIONAL INFORMATION

If more than one screen,
show locations of each on sketch.