

MISSISSIPPI DEPARTMENT OF NATURAL RESOURCES

Bureau of Land and Water Resources

Southport Mall

P.O. Box 10631

Jackson, Mississippi 39209

WATER WELL DRILLERS LOG

CODED

Sunflower
S 56
4-16-86

4-16-86
date well completed

19 Irrigation Equipment
firm name

Sunflower
county well located

LANDOWNER: <u>Matt McGeogor</u>	description of formations encountered	from	to
<u>204 BAYOU DRIVE</u>	<u>clay</u>	<u>0</u>	<u>15</u>
<u>INDIANOLA MS 38751</u> (mailing address)	<u>Fine sand</u>	<u>15</u>	<u>30</u>
<u>WELL LOCATION:</u>	<u>coarse sand</u>	<u>30</u>	<u>55</u>
sec. <u>9 T 17 N</u> R. <u>5 E</u>	<u>coarse sand/pea gravel</u>	<u>55</u>	<u>103</u>
<u>9</u> miles <u>WEST</u> of <u>Duverness</u> (distance) (direction) (nearest town)			
<u>WELL PURPOSE: RICE</u> (home, irrigation, municipal, industrial)			
<u>WELL COMPLETION DATA:</u>			
(1) diameter (inches) <u>8"</u>			
(2) total depth (feet) <u>103</u>			
(3) static water level (feet) <u>29</u> below top of ground.			
(4) casing <u>PVC</u> , <u>63'</u> (material) (depth)			
<u>8"</u> if telescope see back. (size)			
(5) screen <u>40'</u> , <u>63'</u> (length) (depth to top)			
<u>8"</u> , <u>PVC</u> (size) (material)			
(6) pump <u>10</u> , <u>600</u> (HP) (yield gpm)			
<u>Electric</u> (type power)			
(7) electric log <u>NO</u> (yes or no)			
<u>(organization running log)</u>			
(8) how well bottom plugged <u>PVC CAP</u>			
<u>DRILLERS REMARKS:</u>			
<u># 86105MGS01</u>			

CODED


INDIANOLA MISSISSIPPI
MAY 7 1986

Department of Natural Resources
Bureau of Land and Water Resources

If well telescopes please sketch and show depths.

IRRIGATION EQUIPMENT
601/837-2555
INDIANOLA, MS

GROUND LEVEL

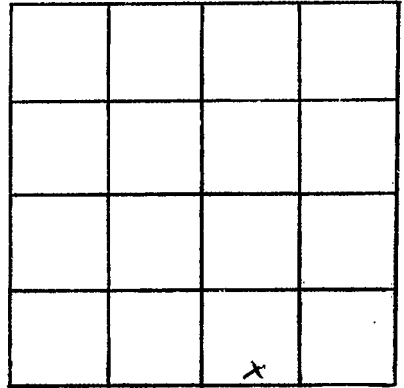

SECTION 9

Please indicate well location X.

ADDITIONAL INFORMATION

If more than one screen,
show locations of each on sketch.