

SUNFLOWER
S59

MISSISSIPPI DEPARTMENT OF NATURAL RESOURCES
 Bureau of Land and Water Resources
 Southport Mall
 P.O. Box 10631
 Jackson, Mississippi 39209
WATER WELL DRILLERS LOG

CODED

7-8-86 19 IRRIGATION EQUIPMENT SUNFLOWER
 date well completed firm name county well located

LANDOWNER: ALLAN POTTER
Rt. 1, Box T-51
Leland, ms 38756
 (mailing address)


description of formations encountered	from	to
CLAY	0	10
FINE SAND	10	35
COARSE SAND	35	55
FINE SAND	55	70
COARSE SAND / pea gravel	70	115

WELL LOCATION:
 sec. 32 T 17 N R 5 E
6 miles SW of Knock
 (distance) (direction) (nearest town)

WELL PURPOSE: Pivot
 (home, irrigation, municipal, industrial)

WELL COMPLETION DATA:
 (1) diameter (inches) 12"
 (2) total depth (feet) 115
 (3) static water level (feet) 29 below top of ground.
 (4) casing steel 75'
12" (material) (depth)
 (size) if telescope see back.
 (5) screen 40' 75'
12" (length) (depth to top)
 (size) STEEL (material)
 (6) pump 60 1000
 (HP) (yield gpm)
diesel (type power)
 (7) electric log NO (yes or no)
 (organization running log) STEEL PLATE
 (8) how well bottom plugged

CODED

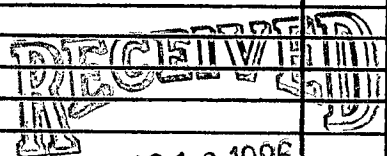


Department of Natural Resources
 Bureau of Land & Water

DRILLERS REMARKS:

If well telescopes please sketch and show depths.

IRRIGATION EQUIPMENT
601/887-2555
INDIANOLA, MS

GROUND LEVEL

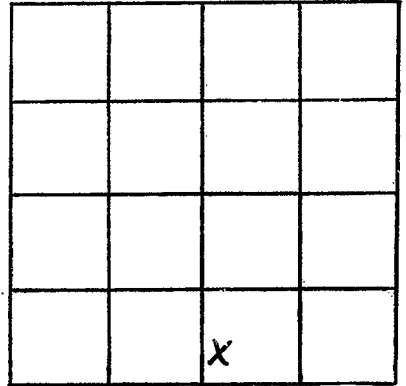

SECTION 32

Please indicate well location X.

ADDITIONAL INFORMATION

If more than one screen,
show locations of each on sketch.