

MISSISSIPPI DEPARTMENT OF NATURAL RESOURCES

Bureau of Land and Water Resources

Southport Mall

P.O. Box 10631

Jackson, Mississippi 39209

WATER WELL DRILLERS LOG

Sunflower
562
147C

Colored

8-9 1987 J-K ITH'SATION SUNFLOWER
 date well completed firm name county well located

LANDOWNER: Bruce Brumfield
Inverness, Miss
 (mailing address)

description of formations encountered	from	to
CLAY	0	19
FINE SAND	19	41
C. SAND & GRAVEL	41	114

WELL LOCATION:
 sec. 27 T. 17 N. R. 5 ^W
8 miles SW of Inverness
 (distance) (direction) (nearest town)

WELL PURPOSE: LWS
 (home, irrigation, municipal, industrial)

- WELL COMPLETION DATA:
- (1) diameter (inches) 16^{1/2}
 - (2) total depth (feet) 114
 - (3) static water level (feet) 21 below above top of ground.
 - (4) casing Steel, 84',
 (material) (depth)
16" if telescope see back.
 (size)
 - (5) screen 40, 84'
 (length) (depth to top)
16", Steel
 (size) (material)
 - (6) pump 50, 2500
 (HP) (yield gpm)
Diesel
 (type power)
 - (7) electric log NO
 (yes or no)
- (organization running log)
- (8) how well bottom plugged PLATE


RECEIVED
 NOV 12 1987

Department of Natural Resources
 Bureau of Land & Water Resources

DRILLERS REMARKS:

If well telescopes please
sketch and show depths.

GROUND LEVEL

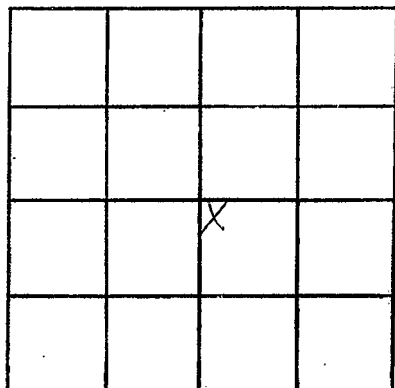

SECTION _____

Please indicate well location X.

ADDITIONAL INFORMATION

If more than one screen,
show locations of each on sketch.