

MISSISSIPPI DEPARTMENT OF NATURAL RESOURCES

Bureau of Land and Water Resources

Southport Mall

P.O. Box 10631

Jackson, Mississippi 39209

WATER WELL DRILLERS LOG

SUNFLOWER
563
147C

Coded

~~1987~~ 6-10 19 87 JO IRRIGATION SUNFLOWER
 date well completed firm name county well located


LANDOWNER: Bruce Blumfeld
Inverness, MISS
 (mailing address)

description of formations encountered	from	to
CLAY	8	19
Fine SAND	19	32
C. SAND & GRAVEL	32	115

WELL LOCATION:
 sec. 26 T 17 N R. 5 W
7 miles SW of Inverness
 (distance) (direction) (nearest town)

WELL PURPOSE: Fish
 (home, irrigation, municipal, industrial)

- WELL COMPLETION DATA:
- (1) diameter (inches) 16"
 - (2) total depth (feet) 115
 - (3) static water level (feet) 21 below above top of ground.
 - (4) casing Steel, 85
 (material) (depth)
16" if telescope see back.
 (size)
 - (5) screen 40', 85
 (length) (depth to top)
16", Steel
 (size) (material)
 - (6) pump 50, 2800
 (HP) (yield gpm)
Diesel
 (type power)
 - (7) electric log NO
 (yes or no)

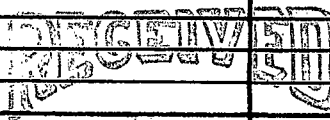

NOV 12 1987

(organization running log)

Department of Natural Resources
 Bureau of Land & Water Resources

(8) how well bottom plugged PLATA

DRILLERS REMARKS:

If well telescopes please
sketch and show depths.

GROUND LEVEL

			X

SECTION 26

Please indicate well location X.

ADDITIONAL INFORMATION

If more than one screen,
show locations of each on sketch.