

SUNFLOWER
 564
 147C

MISSISSIPPI DEPARTMENT OF NATURAL RESOURCES
 Bureau of Land and Water Resources
 Southport Mall
 P.O. Box 10631
 Jackson, Mississippi 39209
WATER WELL DRILLERS LOG

Waded

~~12~~ 6-12 1987 JK ILLIATION SUNFLOWER
 date well completed firm name county well located

LANDOWNER: Bruce Brumfield
 INVERNESS, MISS
 (mailing address)

| description of formations encountered | from | to |
|---------------------------------------|------|-----|
| CLAY | 0 | 17 |
| FINE SAND | 17 | 41 |
| SAND & GRAVEL | 41 | 113 |

WELL LOCATION:
 sec. 26 T 17 N R 5 W
 9 1/2 miles SW of INVERNESS
 (distance) (direction) (nearest town)

WELL PURPOSE: Fish
 (home, irrigation, municipal, industrial)

- WELL COMPLETION DATA:
- (1) diameter (inches) 16"
 - (2) total depth (feet) 113
 - (3) static water level (feet) 21 below top of ground.
 - (4) casing Steel, 85 (material), (depth)
 16" (size) if telescope see back.
 - (5) screen 40, 85 (length), (depth to top)
 16" (size), Steel (material)
 - (6) pump 50 (HP), 2500 (yield gpm)
 Diesel (type power)
 - (7) electric log ND (yes or no)
- (organization running log)
- (8) how well bottom plugged PLATE


RECEIVED
 NOV 12 1987

Department of Natural Resources
 Bureau of Land & Water Resources

DRILLERS REMARKS:

If well telescopes please
sketch and show depths.

GROUND LEVEL

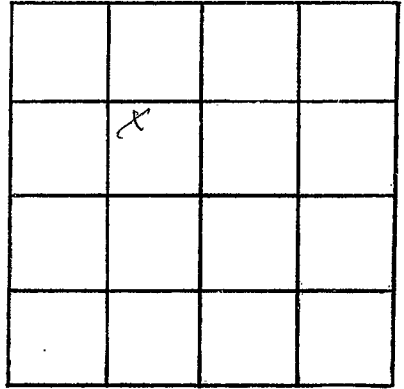

SECTION 26

Please indicate well location X.

ADDITIONAL INFORMATION

If more than one screen,
show locations of each on sketch.