

MISSISSIPPI DEPARTMENT OF NATURAL RESOURCES

Bureau of Land and Water Resources

Southport Mall

P.O. Box 10631

Jackson, Mississippi 39209

WATER WELL DRILLERS LOG

SUNFLOWER  
S 72

CODED

4-21-88 Scholtz Drilling Sunflower  
date well completed firm name county well located

LANDOWNER: DILLARD LAND CO.	description of formations encountered	from	to
Pt. 1, Box 251	CLAY	0	10
Teland ms. 38756 (mailing address)	SAND	10	100
	SAND & GRAVEL	100	125
<b>WELL LOCATION:</b>			
sec. 17 T. 17 N. R. 5 E. S. 5 W. of Inverness			
(distance) miles (direction) of (nearest town)			
<b>WELL PURPOSE:</b> IRRIGATION (home, irrigation, municipal, industrial)			
<b>WELL COMPLETION DATA:</b>			
(1) diameter (inches) 16"			
(2) total depth (feet) 125'			
(3) static water level (feet) 31' below top of ground.			
(4) casing Steel 85' (material) (depth)			
(5) screen 40' 85' (length) (depth to top)			
16" (size) Steel (material)			
(6) pump 60 3000 (HP) (yield gpm)			
pto (type power)			
(7) electric log NO (yes or no)			
X (organization running log)			
(8) how well bottom plugged CAP			
<b>DRILLERS REMARKS:</b>			


RECEIVED

JUN 16 1988

Department of Natural Resources  
Bureau of Land & Water Resources

If well telescopes please sketch and show depths.

GROUND LEVEL

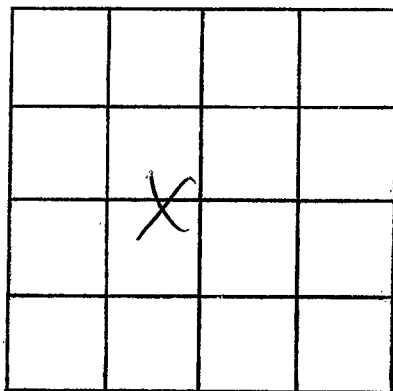

SECTION 17

Please indicate well location X.

ADDITIONAL INFORMATION

If more than one screen,  
show locations of each on sketch.