

MISSISSIPPI DEPARTMENT OF NATURAL RESOURCES

Bureau of Land and Water Resources

Southport Mall

P.O. Box 10631

Jackson, Mississippi 39209

WATER WELL DRILLERS LOG

SUNFLOWER
573

CODED

4-21

1988

Schultz Drilling

Sunflower

date well completed

firm name

county well located

LANDOWNER: <u>DILLARD LAND CO.</u> <u>Pt. 1, Box 251</u> <u>Leban, Mo. 38750</u> (mailing address)	description of formations encountered	from	to
	<u>CLAY</u>	<u>0</u>	<u>10</u>
	<u>SAND</u>	<u>10</u>	<u>100</u>
	<u>SAND + GRAVEL</u>	<u>100</u>	<u>125</u>
WELL LOCATION:			
sec. <u>20</u> T. <u>17</u> N. R. <u>5</u> E. S. <u>5</u>			
<u>5</u> miles <u>W</u> of <u>Invenzo</u>			
(distance) (direction) (nearest town)			
WELL PURPOSE: <u>IRRIGATION</u>			
(home, irrigation, municipal, industrial)			
WELL COMPLETION DATA:			
(1) diameter (inches) <u>16"</u>			
(2) total depth (feet) <u>125'</u>			
(3) static water level (feet) <u>31</u> below ^{above} top of ground.			
(4) casing <u>Steel</u> <u>85'</u>			
(material) (depth)			
_____ (size) if telescope see back.			
(5) screen <u>40</u> <u>85'</u>			
(length) (depth to top)			
<u>16"</u> <u>Steel</u>			
(size) (material)			
(6) pump <u>60</u> <u>3000</u>			
(HP) (yield gpm)			
<u>pto</u>			
(type power)			
(7) electric log <u>No</u>			
(yes or no)			
<u>X</u>			
(organization running log)			
(8) how well bottom plugged <u>CAP</u>			

RECEIVED


JUN 16 1988

DRILLERS REMARKS:

Department of Natural Resources
Bureau of Land and Water Resources

If well telescopes please sketch and show depths.

GROUND LEVEL

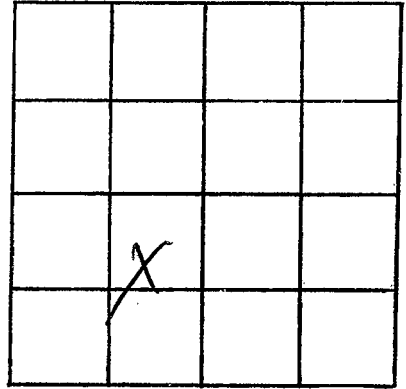

SECTION 20

Please indicate well location X.

ADDITIONAL INFORMATION

If more than one screen,
show locations of each on sketch.