

MISSISSIPPI DEPARTMENT OF NATURAL RESOURCES

Bureau of Land and Water Resources

Southport Mall

P.O. Box 10631

Jackson, Mississippi 39209

WATER WELL DRILLERS LOG

*Sunflower*  
**S 74**

CODED

5-9 1988 date well completed      Schultz Drilling firm name      Sunflower county well located

LANDOWNER:	description of formations encountered	from	to
MARK Potter Rt. 1 Box P51	CLAY	0	10
Leland MS (mailing address)	SAND	-10	100
WELL LOCATION: sec. <u>32</u> T <u>17</u> N R <u>S</u> E 6 miles W of Inverness (distance) (direction) (nearest town)	SAND + peat gravel	100	120
WELL PURPOSE: <u>IRRIGATION</u> (home, irrigation, municipal, industrial)			
WELL COMPLETION DATA:			
(1) diameter (inches) <u>12"</u>			
(2) total depth (feet) <u>120'</u>			
(3) static water level (feet) <u>31'</u> below/above top of ground.			
(4) casing <u>PVC</u> <u>80'</u> (material) (depth)			
(5) screen <u>40'</u> <u>80'</u> (size) (length) (depth to top)			
(6) pump <u>40</u> <u>1500</u> (HP) (yield gpm)			
(7) electric log <u>No</u> (yes or no)			
(8) how well bottom plugged <u>cap</u>			
DRILLERS REMARKS:			


RECEIVED

JUN 16 1988

Department of Natural Resources  
 Bureau of Land & Water Resources

If well telescopes please sketch and show depths.

GROUND LEVEL

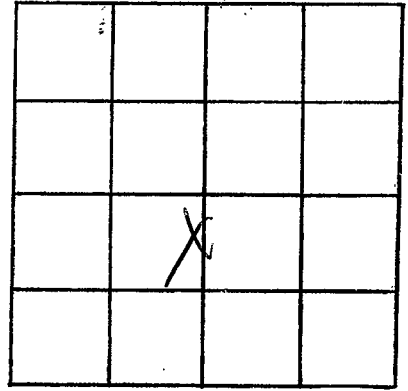

32

SECTION \_\_\_\_\_

Please indicate well location X.

ADDITIONAL INFORMATION

If more than one screen, show locations of each on sketch.