

MISSISSIPPI DEPARTMENT OF NATURAL RESOURCES

Bureau of Land and Water Resources

Southport Mall

P.O. Box 10631

Jackson, Mississippi 39209

WATER WELL DRILLERS LOG

Sunflower
575 CODED

5-13 1988 date well completed Scholtz Drilling firm name Sunflower county well located

LANDOWNER: Dale Stokes	description of formations encountered	from	to
Anola ms. 38722 (mailing address)	CLAY	0	10
	FINE SAND	10	30
	COARSE SAND	50	116
WELL LOCATION:			
sec. <u>31</u> T <u>11</u> N R <u>S</u> E <u>6</u> miles <u>W</u> of <u>Inverness</u> (distance) (direction) (nearest town)			
WELL PURPOSE: <u>IRRIGATION</u> (home, irrigation, municipal, industrial)			
WELL COMPLETION DATA:			
(1) diameter (inches) <u>16"</u>			
(2) total depth (feet) <u>116'</u>			
(3) static water level (feet) <u>32'</u> below/above top of ground.			
(4) casing <u>PVC</u> , <u>76'</u> (material) (depth)			
_____ if telescope see back. (size)			
(5) screen <u>40'</u> <u>76'</u> (length) (depth to top)			
<u>16"</u> <u>PVC</u> (size) (material)			
(6) pump <u>0</u> <u>3000</u> (HP) (yield gpm)			
_____ (type power)			
(7) electric log <u>NO</u> (yes or no)			
_____ <u>X</u> (organization running log)			
(8) how well bottom plugged <u>CAY</u>			

RECEIVED


JUN 16 1988

Department of Natural Resources
 Bureau of Land & Water Resources

DRILLERS REMARKS:

If well telescopes please
sketch and show depths.

GROUND LEVEL

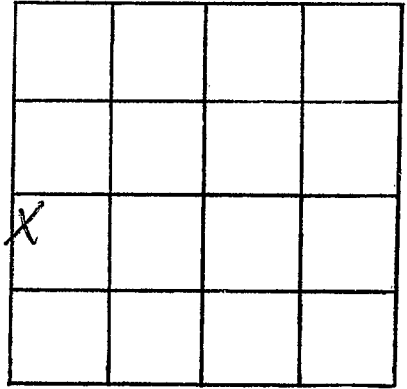

SECTION 31

Please indicate well location X.

ADDITIONAL INFORMATION

If more than one screen,
show locations of each on sketch.