

MISSISSIPPI DEPARTMENT OF NATURAL RESOURCES

Bureau of Land and Water Resources

Southport Mall

P.O. Box 10631

Jackson, Mississippi 39209

WATER WELL DRILLERS LOG

Sheraton
 S 2000

July 25 19 85 *Lump's well pump* *Southern*
 date well completed firm name county well located

LANDOWNER: <i>Martin Hawkins</i>	description of formations encountered	from	to
<i>Isola, ms.</i> (mailing address)	<i>SAND</i>	<i>890</i>	<i>1000</i>
WELL LOCATION: sec. <i>36</i> T. <i>17N</i> R. <i>5</i> E S <i>5</i> CW <i>6</i> miles <i>W</i> of <i>Isola</i> (distance) (direction) (nearest town)			
WELL PURPOSE: (home, irrigation, municipal, industrial)			
WELL COMPLETION DATA:			
(1) diameter (inches) <i>4" x 2"</i>			
(2) total depth (feet) <i>1000</i>			
(3) static water level (feet) <i>22</i> below above top of ground.			
(4) casing <i>PVC</i> , <i>950</i> , (material) (depth)			
<i>4x2</i> If telescope see back. (size)			
(5) screen <i>50'</i> , <i>950 to 1000</i> (length) (depth to top)			
<i>2"</i> , <i>PVC</i> (size) (material)			
(6) pump <i>1</i> , <i>20</i> (HP) (yield gpm)			
<i>220</i> (type power)			
(7) electric log <i>NO</i> (yes or no)			
(organization running log)			
(8) how well bottom plugged <i>shut</i>			
DRILLERS REMARKS:			

RECEIVED

MAY 11 1987

Department of Natural Resources
 Bureau of Land & Water Resources


If well telescopes please sketch and show depths.

GROUND LEVEL

140' 4" P.V.C.

810' 2" P.V.C.

50' 2" screen P.V.C.

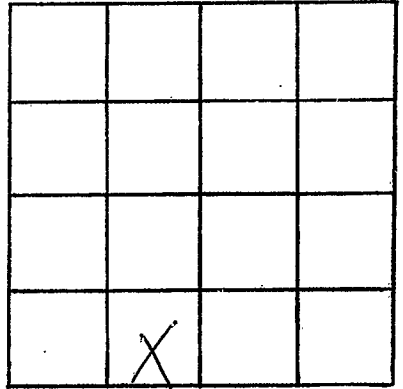

SECTION 36

Please indicate well location X.

ADDITIONAL INFORMATION

If more than one screen, show locations of each on sketch.