

SUN F. MISSISSIPPI BOARD OF WATER COMMISSIONERS

T 12
8-2-57

WATER WELL DRILLERS LOG

CODED ^{8/24/65}
420

Date: August 2, 19 57, Driller: Layne-Central Company County Sunflower
(Name)

(1) Owner of Land: <u>Dozier Lester</u> (Name) <u>Inverness, Mississippi</u> (Address)	Description & Color of Materials Sand, Clay, Red Clay, Shell, etc.	Thickness Feet	Depth Feet
		<u>Clay</u>	<u>22</u>
(2) Location: $\frac{1}{4}$, $\frac{1}{4}$, Sec. <u>10 T 17 R 4</u> <u>2 miles southeast</u> of <u>Inverness</u> (distance) (direction) (Nearest Town)	<u>Fine sand</u>	<u>6</u>	<u>50</u>
	<u>Coarse sand</u>	<u>29</u>	<u>79</u>
(3) Topography: <u>flat</u> (Hilly) (Flat) (Level)	<u>Coarse sand & pea gravel</u>	<u>30</u>	<u>109</u>
(4) Purpose of Well: <u>irrigation</u> (Domestic Irrigation Municipal, Industrial, Other)			

Information upon completion of well:

(1) Diameter 12 inches.

(2) Total Depth 109 feet.

(3) Water Level 17' 2" feet below top of ground.

(4) Cased to 69', Size 12"

(5) Screen: Size 12", Length 40'


(6) Were any formations sealed against pollution?
no yes, no no.

If YES depth of formation _____

Why _____

Drillers Remarks:
1200 GPM.
Engine drive.

CODED

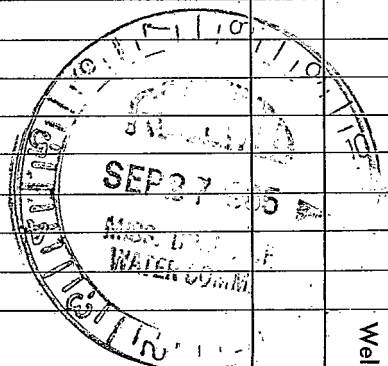

(Use Back Side)

Well No.

