

CODED

SUNFLOWER

T 26

1-6-69

MISSISSIPPI BOARD OF WATER COMMISSIONERS
416 North State Street
Jackson, Mississippi 39201

CODED

WATER WELL DRILLERS LOG

SUNFLOWER
HARRIS

1-6
date well completed

1969 DYER NEW IRRIG

firm name

county well located

LANDOWNER:

LESTER MEYERS

R. R. ISALA, MISS.
(mailing address)

WELL LOCATION:

sec 36 T 17 N R 4 E
4 1/2 miles N.E. of ISALA
(distance) (direction) (nearest town)

WELL PURPOSE: HOME
(home, irrigation, municipal, industrial)

WELL COMPLETION DATA:

- (1) diameter (inches) 4" x 2"
- (2) total depth (feet) 887'
- (3) static water level (feet) 14' below top of ground.
- (4) casing 2" GALV 699' (material) (depth)

If telescope see back.
(size)

- (5) screen 30' 857' (length) (depth to top)
2" STAINLESS STEEL (size) (material)

- (6) pump 1 1/2 25 (HP) (yield gpm)
ELEC (type power)

- (7) electric log N.O. (yes or no)

(organization running log)

- (8) how well bottom plugged NONE

DRILLERS REMARKS:

description of formations encountered

from

to

CLAY	0	12
SAND	12	72
SAND + PEA. GRA.	72	134
CLAY	134	168
SAND	168	205
SANDY SHALE	205	325
Gummy SHALE	325	379
SAND	379	414
CLAY + SAND ST.	414	514
ROCK	514	515
SANDY SHALE	515	528
ROCK	528	529
SANDY SHALE	529	572
Gummy SHALE	572	731
SAND	731	741
CLAY	741	855
SAND	855	887
CLAY	887	900


FEB 17 1969

MISS. BD. OF
WATER COMM.

If well telescopes please sketch and show depths.

GROUND LEVEL

*connected with
sledge hammer.
no tap pipe.*

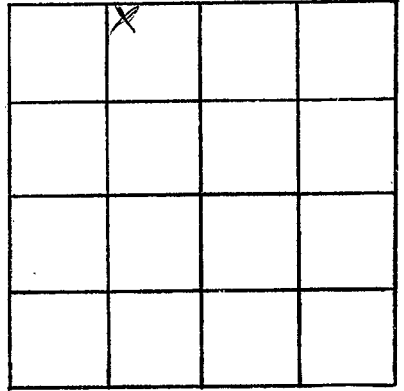

SECTION 36

Please indicate well location X.

ADDITIONAL INFORMATION

If more than one screen,
show locations of each on sketch.