

SUNFLOWER  
T28  
S-2-79

MISSISSIPPI  
BOARD OF WATER COMMISSIONERS  
416 North State Street  
Jackson, Mississippi 39201 CODED

WATER WELL DRILLERS LOG

DYER WELL & IRRIGATION SERVICE

SUNFLOWER  
county well located

MAY 2 1979  
date well completed

firm name

LANDOWNER:

L. A. DAVIDSON

description of formations encountered

from

to

CLAY

0

17

FINE SAND

17

31

COARSE SAND + PEA ROCK

31

43

PEA ROCK SAND +

43

GRAVEL

110'

WELL LOCATION:

sec 33 T 17 N R 4 E  
4 1/2 miles N.W. of ISOLA  
(distance) (direction) (nearest town)

WELL PURPOSE: IRR.  
(home, irrigation, municipal, industrial)

WELL COMPLETION DATA:

- (1) diameter (inches) 16"
- (2) total depth (feet) 110'
- (3) static water level (feet) 16' below top of ground.
- (4) casing PUR IR, 70'  
(material) (depth)  
16" if telescope see back.  
(size)
- (5) screen 40', 70'  
(length) (depth to top)  
16", BLK INLOT  
(size) (material)
- (6) pump 60 3000  
(HP) (yield gpm)
- ELEC.  
(type power)
- (7) electric log No  
(yes or no)

(organization running log)

(8) how well bottom plugged PLATE

DRILLERS REMARKS:


CODED

REGISTERED  
NOV 21 1974

MISS. BD. OF WATER

If well telescopes please sketch and show depths.

GROUND LEVEL

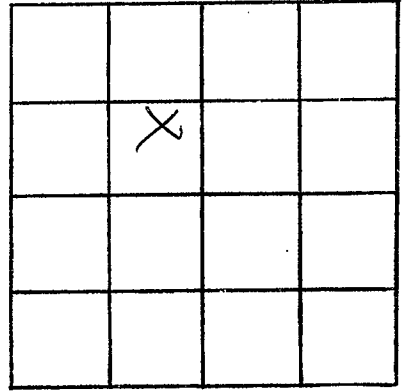

SECTION 83

Please indicate well location X.

ADDITIONAL INFORMATION

If more than one screen,  
show locations of each on sketch.