

SUNFLOWER
T 29
8-68

MISSISSIPPI
BOARD OF WATER COMMISSIONERS
416 North State Street
Jackson, Mississippi 39201

WATER WELL DRILLERS LOG

Aug 12 - 68 Full County Farmers Assn Sunflower
date well completed firm name county well located

LANDOWNER: W.H. STOVALL

Clarkson, La.
Miss
(mailing address)

description of formations encountered	from	to
Clay	0	46 1/2
Sandy Gravel	46 1/2	124 1/2
Rock at	124 1/2	

WELL LOCATION:

sec. 2 T 17 N R 4 E
3 miles SE of INTERNESS
(distance) (direction) (nearest town)

WELL PURPOSE: Irrigation
(home, irrigation, municipal, industrial)

WELL COMPLETION DATA:

- (1) diameter (inches) 14
- (2) total depth (feet) 118.9
- (3) static water level (feet) 14 below top of ground.
- (4) casing Pipe 70' (material) (depth)
14 (size) if telescope see back.
- (5) screen 48 70' (length) (depth to top)
14 (size) Down 101 (material)
- (6) pump 30 2000 (HP) (yield gpm)
Cont. 2+4 (type power)
- (7) electric log NO (yes or no)

EO

(organization running log)

(8) how well bottom plugged welded


AUG 13 1968

MISS. BD. OF
WATER COMM.

DRILLERS REMARKS:

If well telescopes please sketch and show depths.

GROUND LEVEL

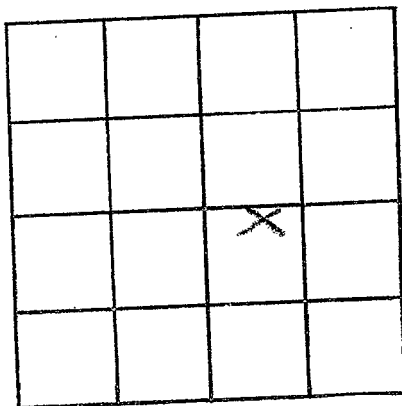

SECTION 2

Please indicate well location X.

ADDITIONAL INFORMATION

If more than one screen, show locations of each on sketch.