

SUNF.

MISSISSIPPI BOARD OF WATER COMMISSIONERS

T 30
4-2-65

9835 WATER WELL DRILLERS LOG

4/11/65
C1939

Date: April 2, 1965, Driller: Layne-Central Company County Sunflower

(Name)

(1) Owner of Land: V. E. Lester

(Name)

Inverness, Mississippi

(Address)

(2) Location: 1/4, 1/4, Sec. 30 T17N R4W

6 miles west of Inverness
(distance) (direction) (Nearest Town)

(3) Topography: flat

(Hilly) (Flat) (Level)

(4) Purpose of Well: domestic

(Domestic Irrigation
Municipal, Industrial, Other)

Description & Color of Materials Sand, Clay, Red Clay, Shell, etc.	Thick- ness Feet	Depth Feet
Clay	25	25
Blue clay	15	40
Fine sand	10	50
Coarse sand	30	80
Coarse sand & pea gravel	14	94
Coarse sand & gravel	32	126
Coarse sand & pea gravel	31	157
Coarse sand	9	166
Clay	24	190
Fine mulky sand, strks. clay	23	213
Sand	70	283
Sand strks. clay & Lignite	32	315
Sand strks. Lignite	47	362
Sand	98	460
Clay	66	526
Sandy shale, strks. sand	30	556
Shale	15	571
Sandy shale	11	582
Sand	50	632
Clay	23	655
Sand	17	672
Sandy shale, strks. sand	25	697
Sand, strks, brown shale	22	719
Fine sand & strks. brown shale	21	740
Sandy shale	33	773
Sand	37	810
Sandy shale, strks. sand	17	827
Sand, strks. Lignite	79	906
Shale	12	918

Information upon completion of well:

(1) Diameter 4 inches.

(2) Total Depth 918 feet.

(3) Water Level 14'-7" feet below top of ground.

(4) Cased to 856'-5", Size 4"

(5) Screen: Size 4" Length 40'-8"
20' -11" of 4" tailpipe


(6) Were any formations sealed against pollution?

yes yes, no.

If YES depth of formation. Packer above the screen and 100 lbs. shot.

Why

Drillers Remarks:

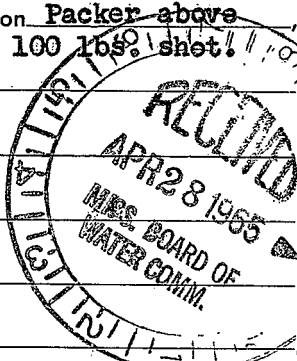

(Use Back Side)

Well No.

