

Sunflower
 T 31
 2-68
 Elec Log

MISSISSIPPI
 BOARD OF WATER COMMISSIONERS
 416 North State Street
 Jackson, Mississippi 39201

WATER WELL DRILLERS LOG

2/16 1968 Boiley Drilling Co. Sunflower
 date well completed firm name county well located

LANDOWNER: R. M. Sumrall
Isola, Miss.
 (mailing address)

description of formations encountered	from	to
Clay	0	10
Sand	10	80
Gravel	80	142
Mud	142	280
Sand	280	320
Mud	320	531
Rock	531	532
Mud	532	560
Sand	560	600
Mud	600	620
Rock	620	621
Mud	621	795
Rock	795	796
Mud	796	835
Rock	835	836
Mud	836	940
Sand	940	960


WELL LOCATION:
 23 25 sec 26 T 17 N R 4 W
 3 miles N of Isola
 (distance) (direction) (nearest town)

WELL PURPOSE:
 (home, irrigation, municipal, industrial)

WELL COMPLETION DATA:

- (1) diameter (inches) 4X2 1/2 X 2
- (2) total depth (feet) 960
- (3) static water level (feet) 25 below top of ground.
- (4) casing steel, 940,
 (material) (depth)
4X2 1/2 X 2 if telescope see back.
 (size)
- (5) screen 20', 940
 (length) (depth to top)
2", stainless steel
 (size) (material)
- (6) pump 2 30
 (HP) (yield gpm)
Elec
 (type power)
- (7) electric log yes
 (yes or no)
Mississippi Geo.
 (organization running log)
- (8) how well bottom plugged
back pressure valve

DRILLERS REMARKS:

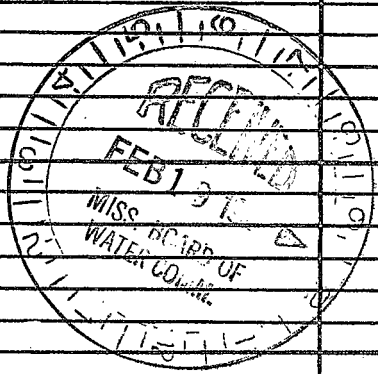

If well telescopes please sketch and show depths.

GROUND LEVEL

141' 4"

110' 5"

79' 7"

50' 3" screen

X			

23

SECTION

Please indicate well location X.

ADDITIONAL INFORMATION

If more than one screen, show locations of each on sketch.