

SUNFLOWER  
T 32  
2-68

MISSISSIPPI  
BOARD OF WATER COMMISSIONERS  
416 North State Street  
Jackson, Mississippi 39201

WATER WELL DRILLERS LOG


2-19 1968 Dyer Well Trer. SUNFLOWER  
date well completed firm name county well located

LANDOWNER: J.W. PAXTON  
R.R.  
ISOLA, Miss.  
(mailing address)  
WELL LOCATION:  
sec. 35 T. 17 N R. 4 E  
2 miles NE of ISOLA  
(distance) (direction) (nearest town)

WELL PURPOSE: HOME  
(home, irrigation, municipal, industrial)

WELL COMPLETION DATA:  
(1) diameter (inches) 2"  
(2) total depth (feet) 1049 FT.  
(3) static water level (feet) 15' below above top of ground.  
(4) casing GALV. PIPE, 1029'  
(material) (depth)  
if telescope see back.  
(size)  
(5) screen 20' 1029'  
(length) (depth to top)  
2" STAINLESS STEEL  
(size) (material)  
(6) pump 1 1/2 18  
(HP) (yield gpm)  
ELEC.  
(type power)  
(7) electric log NO  
(yes or no)  
(organization running log)  
BACK WASID JALDE  
(8) how well bottom plugged


description of fomations encountered	from	to
CLAY	0	18
SAND	18	90
GRAVEL	90	135
CLAY	135	165
SHALE + SAND STRATICS	165	270
SAND	270	325
Gummy SHALE	325	422
SANDY SHALE	422	535
SHALE + CLAY	535	542
ROCK	542	543
SHALE + CLAY	543	745
ROCK	745	748
Gummy SHALE	748	825
SAND	825	835
Gummy SHALE	835	870
SAND	870	880
SAND CLAY	880	897
CLAY SHALE	897	917
Gummy SHALE	917	1022
SAND	1022	1062
CLAY	1062	

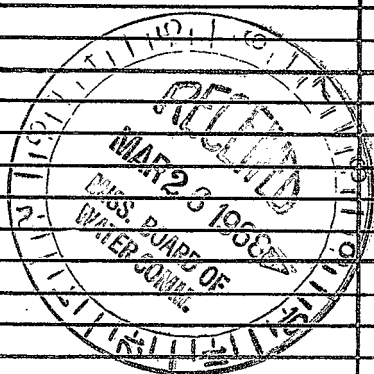

DRILLERS REMARKS:

If well telescopes please sketch and show depths.

GROUND LEVEL

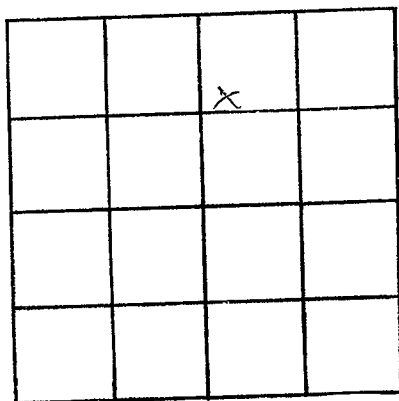

SECTION 35

Please indicate well location X.

ADDITIONAL INFORMATION

If more than one screen, show locations of each on sketch.