

SUNFLOWER
T 35
4-12-75

MISSISSIPPI
 BOARD OF WATER COMMISSIONERS
 416 North State Street
 Jackson, Mississippi 39201

CODED

WATER WELL DRILLERS LOG


April 12, 19 75 Singer-Layne Central Div. Sunflower
 date well completed firm name county well located

LANDOWNER:	description of formations encountered	from	to
Stovall Farms			
Stovall, MS	Top Clay	0	18
(mailing address)	Sandy Clay	18	34
WELL LOCATION:	Coarse Sand	34	89
sec. <u>12</u> T <u>17</u> N R <u>4</u> W	Sand & Pea Gravel	89	119
<u>2</u> miles <u>southeast</u> of <u>Inverness</u>	Coarse Gravel & Sand	119	130
(distance) (direction) (nearest town)			
WELL PURPOSE: <u>irrigation</u>			
(home, irrigation, municipal, industrial)			
WELL COMPLETION DATA:			
(1) diameter (inches) <u>16"</u>			
(2) total depth (feet) <u>130'</u>			
(3) static water level (feet) <u>15</u> below top of ground.			
(4) casing <u>steel</u> <u>80'</u>			
(material) (depth)			
<u>16"</u> if telescope see back.			
(size)			
(5) screen <u>50'</u> <u>80'</u>			
(length) (depth to top)			
<u>16"</u> <u>steel</u>			
(size) (material)			
(6) pump <u>60</u> <u>2800-3000</u>			
(HP) (yield gpm)			
<u>engine</u>			
(type power)			
(7) electric log <u>no</u>			
(yes or no)			
(organization running log)			
(8) how well bottom plugged <u>with plate</u>			
DRILLERS REMARKS:			

RECEIVED
 MAY 19 1975

If well telescopes please sketch and show depths.

GROUND LEVEL

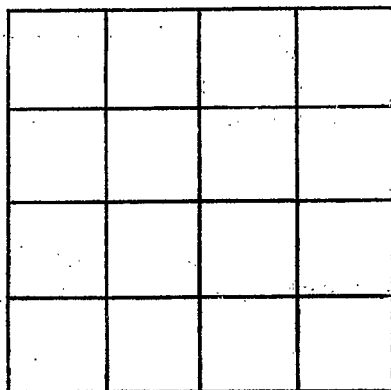

SECTION _____

Please indicate well location X.

ADDITIONAL INFORMATION

If more than one screen,
show locations of each on sketch.