

SUNFLOWER

T 36

C-27-76

BOARD OF WATER COMMISSIONERS
416 North State Street
Jackson, Mississippi 39201

WATER WELL DRILLERS LOG

DIYER-SULLIVAN, INC.

CODED

6-27

1976

date well completed

firm name

SUNFLOWER

county well located

LANDOWNER: Shot Duke

Isola, Miss

(mailing address)

WELL LOCATION:

sec. 36 T 12 N R 4 E
2 miles N of Isola
(distance) (direction) (nearest town)

WELL PURPOSE: Irrigation
(home, irrigation, municipal, industrial)

WELL COMPLETION DATA:

- (1) diameter (inches) 76"
- (2) total depth (feet) 121'
- (3) static water level (feet) 19 below ~~above~~ top of ground.
- (4) casing Steel, 81'
(material) (depth)
16" if telescope see back.
(size)
- (5) screen 40', 81'
(length) (depth to top)
16", Steel
(size) (material)
- (6) pump 60, 2800
(HP) (yield gpm)
Disiel
(type power)
- (7) electric log No
(yes or no)
- (organization running log)
- (8) how well bottom plugged Plate

description of formations encountered

from

to

CLAY	0	19
Fine Sand & Clay	19	31
Sand	31	47
Coarse Sand	47	62
Coarse Sand & Gravel	62	121

CODED


DRILLERS REMARKS:

RECEIVED
AUG 28 1976

MISS. BD. OF WATER COMM.

If well telescopes please sketch and show depths.

GROUND LEVEL

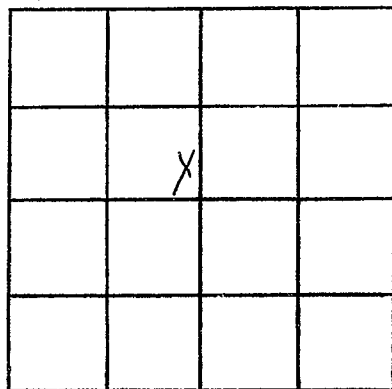

SECTION _____

Please indicate well location X.

ADDITIONAL INFORMATION

If more than one screen,
show locations of each on sketch.