

SUNFLOWER
T 39
3/27/78

MISSISSIPPI
BOARD OF WATER COMMISSIONERS
416 North State Street
Jackson, Mississippi 39201
WATER WELL DRILLERS LOG

CODED

March 27, 1978 date well completed
19 Peterson's Water Wells firm name
Sunflower county well located

LANDOWNER:	description of formations encountered	from	to
R. O. Mallett B-578 Indianola, Mississippi (mailing address)		Top soil Clay White coarse sand	0 5 50
WELL LOCATION:	CODED		
sec. 31 T 17 N R 4 E 5 miles S.W. of Inverness (distance) (direction) (nearest town)			
WELL PURPOSE: (home irrigation, municipal, industrial)	CODED		
WELL COMPLETION DATA:			
(1) diameter (inches) 8"			
(2) total depth (feet) 100'			
(3) static water level (feet) 16' below top of ground.			
(4) casing PVC 160 PVC (material) (depth)			
(size) If telescope see back.			
(5) screen 30' 70' (length) (depth to top)			
8" P.O.C. (size) (material)			
(6) pump 7 1/2 500 (HP) (yield gpm)			
Electric (type power)			
(7) electric log (yes or no)			
(organization running log)			
(8) how well bottom plugged CAPPED			

Miss. Board of Water Comm.


APR 16 1978

RECEIVED

DRILLERS REMARKS:

If well telescopes please sketch and show depths.

GROUND LEVEL

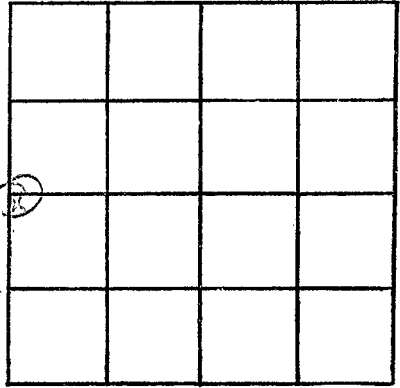

SECTION _____

Please indicate well location X.

ADDITIONAL INFORMATION

If more than one screen,
show locations of each on sketch.