

SUNFLOWERS

~~7-22~~ 7-10

8-20-79

8-20  
date well completed

MISSISSIPPI  
BOARD OF WATER COMMISSIONERS  
416 North State Street  
Jackson, Mississippi 39201

CODED

WATER WELL DRILLERS LOG

79 Larry's Well Pump & Sunflower  
firm name county well located

LANDOWNER: Paul Townsend  
Belzoni Miss.

(mailing address)

WELL LOCATION:

sec. 18 T. 14 N. R. 4 E.  
3 South miles 3 West of Inverness  
(distance) (direction) (nearest town)

WELL PURPOSE: fish pond  
(home, irrigation, municipal, industrial)

WELL COMPLETION DATA:

- (1) diameter (inches) 16"
- (2) total depth (feet) 110'
- (3) static water level (feet) 18' below top of ground.
- (4) casing steel 70' (material) (depth)
- (size) If telescope see back.
- (5) screen 40' 70' (length) (depth to top)  
16" steel (size) (material)
- (6) pump 60 3000 (HP) (yield gpm)
- (type power) D
- (7) electric log (yes or no)
- (organization running log)
- (8) how well bottom plugged steel plate

description of formations encountered	from	to
clay	0	18
fine sand	18	30
med sand	30	50
med coarse sand	50	55
coarse sand	55	90
coarse sand & gravel	90	110

CODED

Miss. Board of Water Comm.


SEP 13 1979

RECEIVED

DRILLERS REMARKS:

If well telescopes please sketch and show depths.

GROUND LEVEL

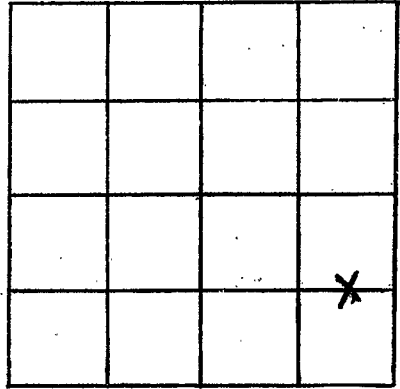

SECTION 18

Please indicate well location X.

ADDITIONAL INFORMATION

If more than one screen, show locations of each on sketch.