

SUNFLOWER  
~~1123~~ 741  
 8-22-79

MISSISSIPPI  
 BOARD OF WATER COMMISSIONERS. CODED  
 416 North State Street  
 Jackson, Mississippi 39201

WATER WELL DRILLERS LOG

8-22 19 79 Larry's Well Drilling Sunflower County  
 date well completed firm name county/well located

LANDOWNER: Paul Townsend  
 Belzoni miss  
 (mailing address)

description of formations encountered	from	to
clay	0	8
fine sand	8	25
fine to med sand	25	65
coarse sand	65	80
course sand/gravel	80	110

WELL LOCATION:  
 sec. 18 T 14 N R 4 E  
 3 South miles 3 West of Inverness  
 (distance) (direction) (nearest town)

CODED

WELL PURPOSE: fish pond  
 (home, irrigation/municipal, industrial)

- WELL COMPLETION DATA:
- (1) diameter (inches) 16"
  - (2) total depth (feet) 110'
  - (3) static water level (feet) 17' below top of ground.
  - (4) casing steel 70' (material) (depth)
  - (size) If telescope see back.
  - (5) screen 40' 70' (length) (depth to top)  
 16" steel (size) (material)
  - (6) pump 60 3000 (HP) (yield gpm)  
 0 (type power)
  - (7) electric log (yes or no)
  - (organization running log)
  - (8) how well bottom plugged at photo

Office Board of Water Comm.


SEP 13 1979

DRILLERS REMARKS:

RECEIVED

If well telescopes please sketch and show depths.

GROUND LEVEL

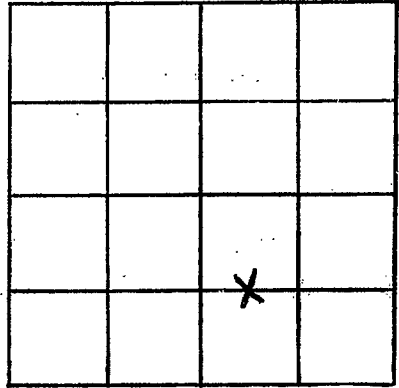

SECTION 18

Please indicate well location X.

ADDITIONAL INFORMATION

If more than one screen,  
show locations of each on sketch.