

SUNFLOWER  
T 42  
8-21-79

MISSISSIPPI  
BOARD OF WATER COMMISSIONERS  
416 North State Street  
Jackson, Mississippi 39201

CODED

WATER WELL DRILLERS LOG

8-21

date well completed

1979 DYER WELL + IRRIGATION

firm name

14 Sunflower

county well located

LANDOWNER: Holly Ridge Pk. Co.

description of formations encountered

from

to

Indianola, Miss.  
(mailing address)

CLAY	0	28
FINE SAND	28	35
SAND	35	55
SAND + GRAVEL	55	113

WELL LOCATION:

sec. 25 T-17 N R-4 E  
1 1/2 miles East of CAILE  
(distance) (direction) (nearest town)

WELL PURPOSE: IRRIGATION  
(home, irrigation, municipal, industrial)

CODED

WELL COMPLETION DATA:


- (1) diameter (inches) 16"
- (2) total depth (feet) 113'
- (3) static water level (feet) 18' below top of ground.
- (4) casing STEEL, 73' (material) (depth)  
16" (size) if telescope see back.
- (5) screen 40' 73' (length) (depth to top)  
16" STEEL (size) (material)
- (6) pump 60 3,000 (HP) (yield gpm)  
DIESEL (type power)
- (7) electric log No (yes or no)  
(organization running log)
- (8) how well bottom plugged PLATE

Rec'd done  
9-24-79

DRILLERS REMARKS:

If well telescopes please sketch and show depths.

GROUND LEVEL

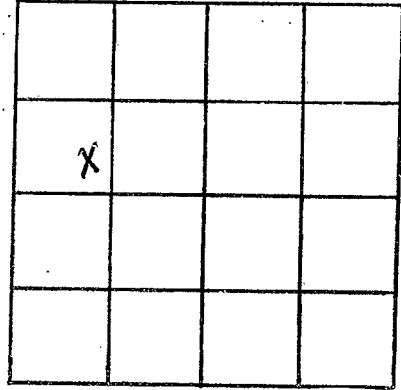

SECTION 25

Please indicate well location X.

ADDITIONAL INFORMATION

Lined area for additional information.

If more than one screen, show locations of each on sketch.