

SUNFLOWER

T43

8-27-79

MISSISSIPPI BOARD OF WATER COMMISSIONERS
416 North State Street
Jackson, Mississippi 39201

CODED

WATER WELL DRILLERS LOG

8-27

1979

DYER WELL & IRRIGATION

Sunflower

date well completed

firm name

county well located

LANDOWNER: Holly Ridge Pitt Co.

description of formations encountered

from

to

Indianola, Miss.
(mailing address)

CLAY

FINE SAND

SAND

SAND & GRAVEL

0

35

35

40

40

58

58

118

CODED

WELL LOCATION:

sec. 25 T. 17 N. R. 4 E. S. 1 E. W. 1
1 1/2 miles East of CAILE
(distance) (direction) (nearest town)

WELL PURPOSE: IRRIGATION
(home, irrigation, municipal, industrial)

WELL COMPLETION DATA:

- (1) diameter (inches) 16"
- (2) total depth (feet) 118'
- (3) static water level (feet) 18' below top of ground.
- (4) casing Steel, 78' (material) (depth)
16" (size) if telescope see back.
- (5) screen 40" 78' (length) (depth to top)
16" Steel (size) (material)
- (6) pump 60 3000 (HP) (yield gpm)
DIESEL (type power)
- (7) electric log No (yes or no)

(organization running log)


(8) how well bottom plugged Plate

Rec'd Am
8-24-79

DRILLERS REMARKS:

If well telescopes please sketch and show depths.

GROUND LEVEL

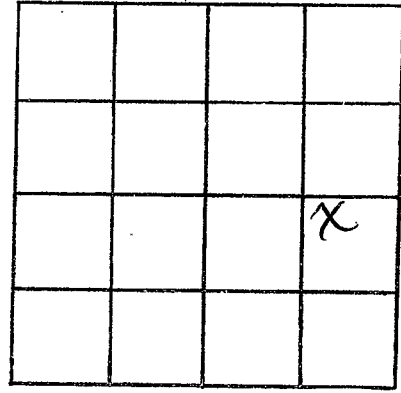

SECTION 25

Please indicate well location X.

ADDITIONAL INFORMATION

A series of horizontal lines for writing additional information, starting below the 'ADDITIONAL INFORMATION' header and extending down to the bottom of the page.

If more than one screen, show locations of each on sketch.