

SUNFLOWER
T 44
8-31-79

MISSISSIPPI
 BOARD OF WATER COMMISSIONERS
 416 North State Street
 Jackson, Mississippi 39201

CODED

WATER WELL DRILLERS LOG

8-31 1979 Larry's Well Pump & Sunflower
 date well completed firm name county well located



LANDOWNER: <u>Paul Townsend</u>	description of formations encountered	from	to
<u>Belzoni miss</u>			
(mailing address)	<u>clay</u>	<u>0</u>	<u>18</u>
WELL LOCATION: <u>17N 4W</u>	<u>fine sand</u>	<u>18</u>	<u>35</u>
sec. <u>18</u> T. <u>14</u> N. R. <u>3</u> E. S. <u>3</u> W.	<u>med sand</u>	<u>35</u>	<u>65</u>
<u>3</u> South miles <u>3</u> West of <u>Inverness</u>	<u>course sand</u>	<u>65</u>	<u>85</u>
(distance) (direction) (nearest town)	<u>course sand & gravel</u>	<u>85</u>	<u>129</u>
WELL PURPOSE: (home, irrigation, municipal, industrial)	<u>clay</u>	<u>129</u>	<u>220</u>
WELL COMPLETION DATA:	<u>fine sand</u>	<u>220</u>	<u>352</u>
(1) diameter (inches) <u>4" 120' 2"-860</u>	<u>clay</u>	<u>352</u>	<u>390</u>
(2) total depth (feet) <u>860</u>	<u>fine sand</u>	<u>390</u>	<u>397</u>
(3) static water level (feet) <u>20</u> <u>below</u> top of ground.	<u>clay</u>	<u>397</u>	<u>400</u>
(4) casing <u>plastic</u> <u>840</u> (material) (depth)	<u>fine sand</u>	<u>400</u>	<u>437</u>
(size) if telescope see back.	<u>clay</u>	<u>437</u>	<u>445</u>
(5) screen <u>20</u> <u>840</u> (length) (depth to top)	<u>fine sand</u>	<u>445</u>	<u>570</u>
<u>2"</u> <u>plastic</u> (size) (material)	<u>clay & sand</u>	<u>570</u>	<u>800</u>
(6) pump <u>1 1/2</u> <u>30</u> (HP) (yield gpm)	<u>med sand & clay</u>	<u>800</u>	<u>815</u>
<u>Electric</u> (type power)	<u>med sand</u>	<u>815</u>	<u>860</u>
(7) electric log (yes or no)			
(organization running log)			
(8) how well bottom plugged <u>Wash valve</u>			
DRILLERS REMARKS:			

CODED

*1979/25/79
 PLD
 PWR*

If well telescopes please sketch and show depths.

GROUND LEVEL

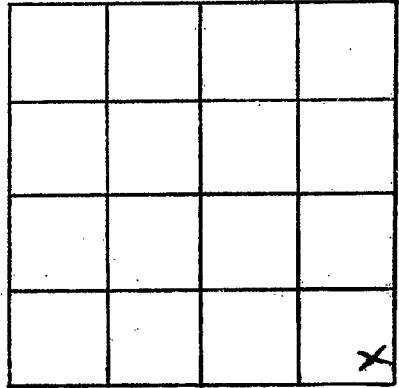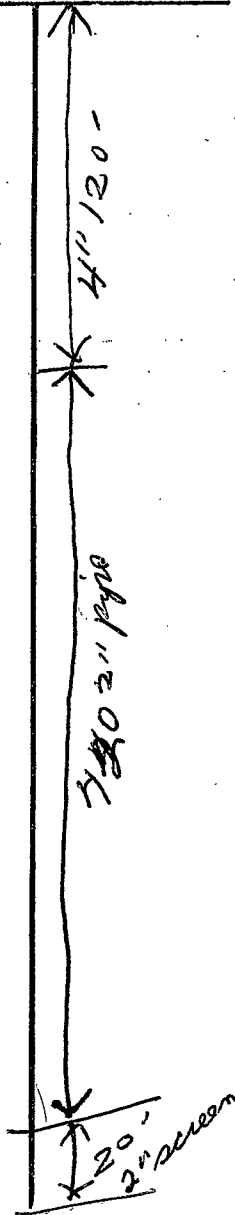

SECTION 18

Please indicate well location X.

ADDITIONAL INFORMATION

If more than one screen, show locations of each on sketch.