

~~SUNFLOWER~~
T45
 5-10-79

MISSISSIPPI
 BOARD OF WATER COMMISSIONERS
 416 North State Street
 Jackson, Mississippi 39201

CODED

WATER WELL DRILLERS LOG

~~SUNFLOWER~~
~~HUMPHREYS~~
~~LEFLORE~~

~~5/10~~ 5/10 1979 DYER WELL + IRR
 date/well completed firm name

county well located

LANDOWNER:
DICK STEVENS
ISOLA
 (mailing address)

description of formations encountered	from	to
CLAY	0	68
SAND	68	70
SAND + GRAVEL	70	115

WELL LOCATION:
 sec. 35 T 17 N R 4 E
 S W
3.1 miles N of ISOLA.
 (distance) (direction) (nearest town)

WELL PURPOSE:
 (home, irrigation, municipal, industrial)

WELL COMPLETION DATA:

(1) diameter (inches) 16"

(2) total depth (feet) 115

(3) static water level (feet) 20 below above top of ground.

(4) casing STEEL, 75'
 (material) (depth)
16 if telescope see back.
 (size)

(5) screen 40', 75'
 (length) (depth to top)
16, STEEL
 (size) (material)

(6) pump 60 3000
 (HP) (yield gpm)
DIESEL
 (type power)

(7) electric log NO
 (yes or no)

(organization running log)

(8) how well bottom plugged PLATE

DRILLERS REMARKS:

DEPT. OF NATURAL RESOURCES
 BUREAU OF LAND & WATER RESOURCES


NOV 13 1979

RECEIVED

If well telescopes please sketch and show depths.

GROUND LEVEL

Sketch of a well telescope with a vertical line and a curved arrow pointing downwards.

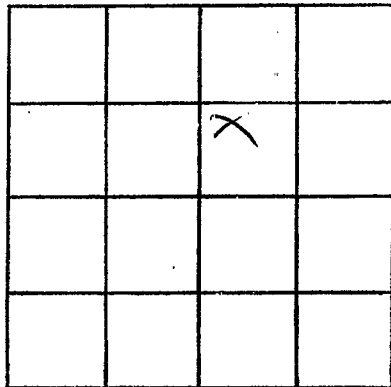

SECTION 35

Please indicate well location X.

ADDITIONAL INFORMATION

Lined area for additional information.

If more than one screen, show locations of each on sketch.