

SUNFLOWER

MISSISSIPPI DEPARTMENT OF NATURAL RESOURCES
Bureau of Land and Water Resources
Southport Mall
P.O. Box 10631
Jackson, Mississippi 39209
WATER WELL DRILLERS LOG

CODED

T-46
5-26-80
5-26

1980 Larry's Well & Pump Sunflower
date well completed firm name county well located

LANDOWNER: Shot Duker
T Solay, ms
(mailing address)

WELL LOCATION:
sec 35 T 17 N R 4 E
1 1/2 miles S of Coile
(distance) (direction) (nearest town)

WELL PURPOSE: industrial
(home, irrigation, municipal, industrial)

WELL COMPLETION DATA:
(1) diameter (inches) 6" x 4"
(2) total depth (feet) 520'
(3) static water level (feet) 24' below top of ground
(4) casing plastic, 480' (material) (depth)
(size) If telescope see back.
(5) screen 40' 480' (length) (depth to top)
4" plastic (size) (material)
(6) pump 3 50 (HP) (yield gpm)
electric (type power)
(7) electric log NO (yes or no)
(organization running log)
(8) how well bottom plugged wash plug

description of formations encountered	from	to
clay	0'	20'
fine sand	20'	35'
med sand	35'	48'
coarse sand	48'	72'
coarse sand & sng gravel	72'	128'
clay	128'	235'
sand	235'	350'
sand & clay	350'	425'
clay	425'	460'
coarse sand	460'	520'

CODED

DEPT OF NATURAL RESOURCES
BUREAU OF LAND & WATER RESOURCES


JUN 30 1980

RECEIVED

DRILLERS REMARKS:

If well telescopes please sketch and show depths.

GROUND LEVEL

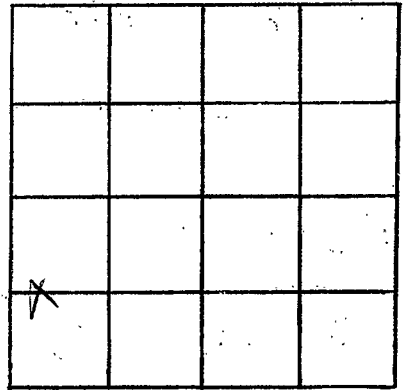

SECTION 35

Please indicate well location X.

ADDITIONAL INFORMATION

If more than one screen, show locations of each on sketch.