

MISSISSIPPI DEPARTMENT OF NATURAL RESOURCES
Bureau of Land and Water Resources
 Southport Mall
 P.O. Box 10631
 Jackson, Mississippi 39209
WATER WELL DRILLERS LOG

CODED

<i>Sunflower</i>
<i>T 51</i>
<i>8/30/80</i>

08/30 19 *80* *Larry's well & Pump* *Sunflower*
 date well completed firm name county well located

LANDOWNER: *Ramey Tinnin*

description of formations encountered	from	to
<i>clay</i>	<i>0</i>	<i>22</i>
<i>fine sand</i>	<i>22</i>	<i>30</i>
<i>med sand</i>	<i>30</i>	<i>50</i>
<i>course sand</i>	<i>50</i>	<i>120</i>

(mailing address)

WELL LOCATION:
 sec. *22* *17* N R *4* E
 S W
1 miles *West* of *Caile*
 (distance) (direction) (nearest town)

CODED

WELL PURPOSE: *Fish Pond*
 (home, irrigation, municipal, industrial)

WELL COMPLETION DATA:

(1) diameter (inches) *16"*
 (2) total depth (feet) *120'*
 (3) static water level (feet) *18* below above top of ground.
 (4) casing *Steel*, *80'*
 (material) (depth)
 (size) if telescope see back.
 (5) screen *40'*, *80'*
 (length) (depth to top)
 16", *Steel*
 (size) (material)
 (6) pump *1/2*, *2000*
 (HP) (yield gpm)
 (type power)
 (7) electric log *No*
 (yes or no)
 (organization running log)
 (8) how well bottom plugged *Steel*
 plate

DRILLERS REMARKS:


DEPT. OF NATURAL RESOURCES
 BUREAU OF LAND & WATER RESOURCES

APR 28 1981

RECEIVED

If well telescopes please sketch and show depths.

GROUND LEVEL

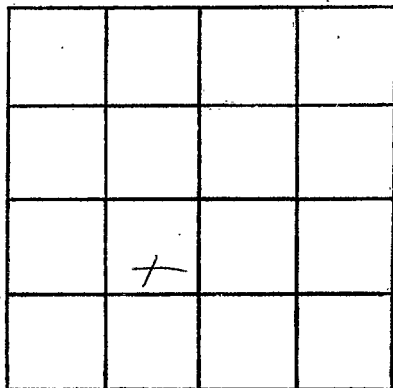

SECTION 22

Please indicate well location X.

ADDITIONAL INFORMATION

If more than one screen, show locations of each on sketch.