

MISSISSIPPI DEPARTMENT OF NATURAL RESOURCES  
Bureau of Land and Water Resources

Southport Mall  
P.O. Box 10631

Jackson, Mississippi 39209

WATER WELL DRILLERS LOG

CODED

SUNFLOWER
T 53
12/19/80

12/19 19 80 date well completed      Larry's well & Pump firm name      Sunflower county well located


LANDOWNER: Cleve Jones  
Inverness, MS. (mailing address)  
description of formations encountered: CLAY (0 to 25), FINE SAND (25 to 66), COURSE SAND GRAVEL (66 to 116)  
from      to

WELL LOCATION:  
sec. 34 T 19 N R 4 E  
3 miles NW of Inverness  
(distance) (direction) (nearest town)

CODED

WELL PURPOSE: FISH Pond  
(home, irrigation, municipal, industrial)


- WELL COMPLETION DATA:
- (1) diameter (inches) 16"
  - (2) total depth (feet) 116'
  - (3) static water level (feet) 22 below above top of ground.
  - (4) casing Steel, 76' (material), (depth), (size) if telescope see back.
  - (5) screen 40', 76' (length), (depth to top) 16", Steel (size), (material)
  - (6) pump 60, 3000 (HP), (yield gpm) (type power)
  - (7) electric log No (yes or no) (organization running log)
  - (8) how well bottom plugged Steel Plate

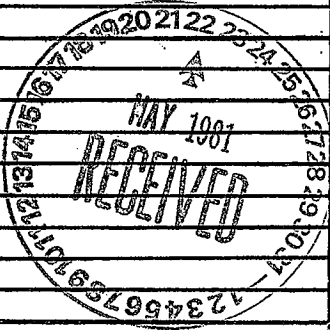

DRILLERS REMARKS:

If well telescopes please  
sketch and show depths.

GROUND LEVEL

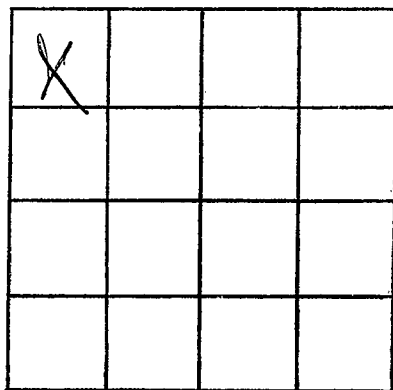

SECTION 34

Please indicate well location X.

ADDITIONAL INFORMATION

If more than one screen,  
show locations of each on sketch.