

SUNFLOWER
T 54
G-10-81

MISSISSIPPI DEPARTMENT OF NATURAL RESOURCES
Bureau of Land and Water Resources
Southport Mall
P.O. Box 10631
Jackson, Mississippi 39209
WATER WELL DRILLERS LOG

CODED

6-10-81 date well completed 19 81 Dyer Well Drilling firm name Sunflower county well located

LANDOWNER: R. D. Mallett

description of formations encountered from to

Oscharola, MS (mailing address)

Clay 0 66
red-fine sand 66 82
sand & gravel 82 108

WELL LOCATION:
sec. 32 T 17 N R. 4 E
3 miles W of Osola
(distance) (direction) (nearest town)

WELL PURPOSE:
(home, irrigation, municipal, industrial)

WELL COMPLETION DATA:

- (1) diameter (inches) 16"
- (2) total depth (feet) 108'
- (3) static water level (feet) 22' below top of ground.
- (4) casing Steel, 108' (material) (depth)
16" (size) if telescope see back.
- (5) screen 40' 68' (length) (depth to top)
16 Steel (size) (material)
- (6) pump 60 3000 (HP) (yield gpm)
Electric (type power)
- (7) electric log (yes or no)

(organization running log)

(8) how well bottom plugged plate

DRILLERS REMARKS:

CODED


DEPT. OF NATURAL RESOURCES
BUREAU OF LAND & WATER RESOURCES

JUN 15 1981

RECEIVED

If well telescopes please sketch and show depths.

GROUND LEVEL

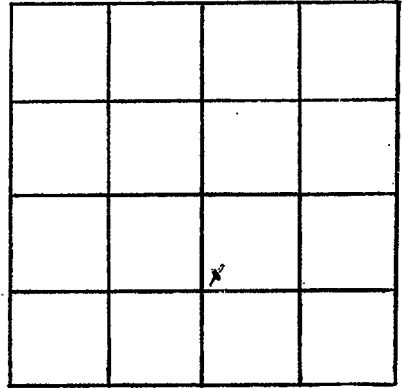

SECTION 32

Please indicate well location X.

ADDITIONAL INFORMATION

If more than one screen,
show locations of each on sketch.