

SUNFLOWER
 T 55
 3-12-81

MISSISSIPPI DEPARTMENT OF NATURAL RESOURCES
 Bureau of Land and Water Resources
 Southport Mall
 P.O. Box 10631
 Jackson, Mississippi 39209
 WATER WELL DRILLERS LOG

CODED

3-12 1981 N. MS. Well drilling Sunflower
 date well completed firm name county well located

LANDOWNER: Mr. Johnson
 Emma's Mrs.
 (mailing address)


description of formations encountered	from	to
Clay	0	20
Sand	20	75

WELL LOCATION:
 sec. 12 T. 17 N. R. 4 E.
 S W
 2 miles S-E Emma's
 (distance) (direction) (nearest town)

Gravel	75	103
--------	----	-----

WELL PURPOSE: Fish Pond
 (home, irrigation, municipal, industrial)


- WELL COMPLETION DATA:
- diameter (inches) 6"
 - total depth (feet) 103
 - static water level (feet) 24 below top of ground.
 - casing Plastic 103
 (material) (depth)
 (size) if telescope see back.
 - screen 20
 (length) (depth to top)
 6" Slot Plastic
 (size) (material)
 - pump 7 1/2 300
 (HP) (yield gpm)
 Elec
 (type power)
 - electric log No
 (yes or no)
 (organization running log)
 - how well bottom plugged Cap

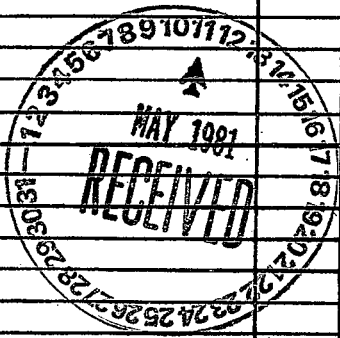

DRILLERS REMARKS:

If well telescopes please sketch and show depths.

GROUND LEVEL

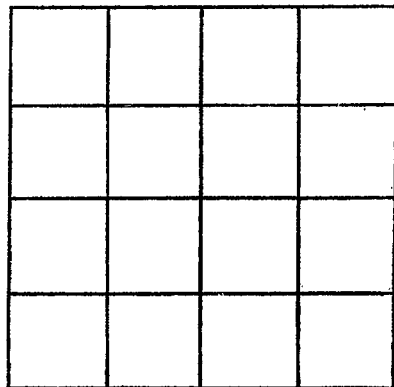

SECTION _____

Please indicate well location X.

ADDITIONAL INFORMATION

If more than one screen,
show locations of each on sketch.