

SUNFLOWER

T 56

3-20-81

MISSISSIPPI DEPARTMENT OF NATURAL RESOURCES

Bureau of Land and Water Resources

Southport Mall

P.O. Box 10631

Jackson, Mississippi 39209

WATER WELL DRILLERS LOG

CODED

3-20 81 N. Man Well Drilling Sun Flower  
date well completed firm name county well located

LANDOWNER: Mr Masey  
Emmora, Ms

description of formations encountered

from to

Clay 0 20

Sand 20 80

Gravel 80 105

(mailing address)

WELL LOCATION:

sec. 13 T. 17 N R. 4 E  
2 miles S-E of Emmora  
(distance) (direction) (nearest town)

WELL PURPOSE: Fish Pond  
(home, irrigation, municipal, industrial)

WELL COMPLETION DATA:

- (1) diameter (inches) 8"
- (2) total depth (feet) 105
- (3) static water level (feet) 25 below above top of ground.
- (4) casing Plastic, 105  
(material) (depth)

if telescope see back.  
(size)

- (5) screen 20  
(length) (depth to top)  
8" Slat Plastic  
(size) (material)

- (6) pump 1/2 500  
(HP) (yield gpm)

Electric  
(type power)


- (7) electric log No  
(yes or no)

(organization running log)

- (8) how well bottom plugged Cap


DRILLERS REMARKS:

CODED

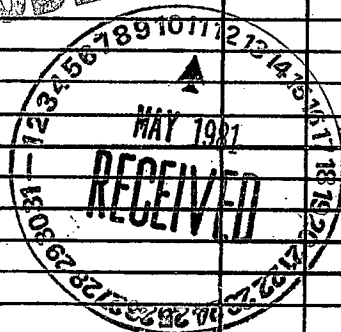

If well telescopes please sketch and show depths.

GROUND LEVEL

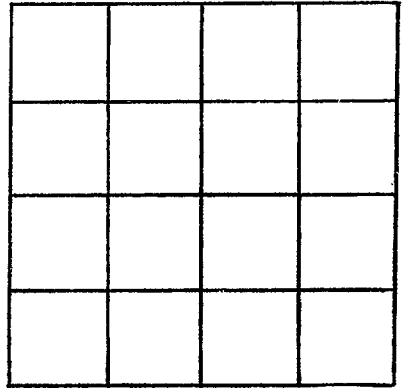

SECTION \_\_\_\_\_

Please indicate well location X.

ADDITIONAL INFORMATION

If more than one screen, show locations of each on sketch.