

MISSISSIPPI DEPARTMENT OF NATURAL RESOURCES

Bureau of Land and Water Resources

Southport Mall

P.O. Box 10631

Jackson, Mississippi 39209

CODED

WATER WELL DRILLERS LOG

Sunflower  
T57  
5-5-81

May 05 1981  
 date well completed

Larry's well & pump  
 firm name

Sunflower  
 county well located

LANDOWNER: Ed Cobb

description of formations encountered

from

to

Belzoni MS  
 (mailing address)

<u>Clay</u>	<u>0</u>	<u>28</u>
<u>Fine Sand</u>	<u>28</u>	<u>55</u>
<u>Coarse Sand</u>	<u>55</u>	<u>122</u>

WELL LOCATION:

sec. 27 T 17 N R 4 E  
6 miles S of Belzoni  
 (distance) (direction) (nearest town)

WELL PURPOSE: Fish Pond  
 (home, irrigation, municipal, industrial)

WELL COMPLETION DATA:

- (1) diameter (inches) 16"
- (2) total depth (feet) 122'
- (3) static water level (feet) 20 below above top of ground.

(4) casing Steel, 82'  
 (material) (depth)

\_\_\_\_\_ if telescope see back.  
 (size)

(5) screen 40", 82'  
 (length) (depth to top)

1 1/2", Steel  
 (size) (material)

(6) pump 60 3000  
 (HP) (yield gpm)

\_\_\_\_\_ (type power)

(7) electric log No  
 (yes or no)

\_\_\_\_\_ (organization running log)

(8) how well bottom plugged Steel  
Plate

DRILLERS REMARKS:

CODED


DEPT. OF NATURAL RESOURCES  
 BUREAU OF LAND & WATER RESOURCES

JUL 16 1981

RECEIVED

If well telescopes please sketch and show depths.

GROUND LEVEL

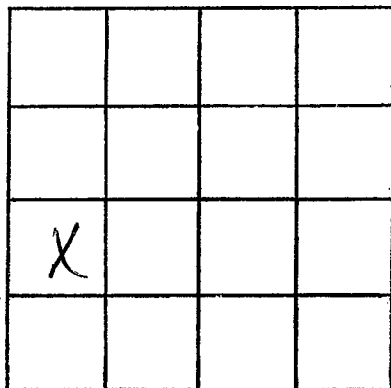

SECTION 27

Please indicate well location X.

ADDITIONAL INFORMATION

If more than one screen,  
show locations of each on sketch.