

MISSISSIPPI DEPARTMENT OF NATURAL RESOURCES

Bureau of Land and Water Resources

Southport Mall

P.O. Box 10631

Jackson, Mississippi 39209

WATER WELL DRILLERS LOG

CODED

Sumflow
T58
5-7-81

May 07 1981 Randy's well & pump Sumflow
 date well completed firm name county well located

LANDOWNER: Irrel Jones
Inverness, ms
 (mailing address)

description of formations encountered	from	to
<u>Clay</u>	<u>0</u>	<u>34</u>
<u>fine sand</u>	<u>34</u>	<u>56</u>
<u>Coarse Sand</u>	<u>56</u>	<u>122</u>

WELL LOCATION:
 sec. 18 T 17 N R 4 W
6 miles SW of Inverness
 (distance) (direction) (nearest town)

WELL PURPOSE: test bond
 (home, irrigation, municipal, industrial)

WELL COMPLETION DATA:

(1) diameter (inches) 16"

(2) total depth (feet) 122'

(3) static water level (feet) 22 below above top of ground.

(4) casing Steel, 82'
 (material) (depth)
 (size) if telescope see back.

(5) screen 40', 82'
 (length) (depth to top)
16", Steel
 (size) (material)

(6) pump 60, 3000
 (HP) (yield gpm)
Electric
 (type power)

(7) electric log NO
 (yes or no)
 (organization running log)

(8) how well bottom plugged Steel Plate

CODED

DEPT. OF NATURAL RESOURCES
 BUREAU OF LAND & WATER RESOURCES


JUL 16 1981

RECEIVED

DRILLERS REMARKS:

If well telescopes please sketch and show depths.

GROUND LEVEL

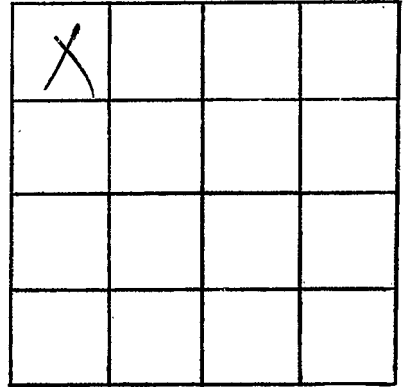

SECTION 18

Please indicate well location X.

ADDITIONAL INFORMATION

If more than one screen, show locations of each on sketch.