

MISSISSIPPI DEPARTMENT OF NATURAL RESOURCES

Bureau of Land and Water Resources

Southport Mall

P.O. Box 10631

Jackson, Mississippi 39209

WATER WELL DRILLERS LOG

CODED

SUNFLOWER
T 59
7-28-81

7-28-1981 date well completed Dyer Well firm name Sunflower county well located

LANDOWNER: James Reed

| description of formations encountered | from | to |
|---------------------------------------|-----------|------------|
| <u>clay</u> | <u>0</u> | <u>28</u> |
| <u>fine sand</u> | <u>28</u> | <u>50</u> |
| <u>sand</u> | <u>50</u> | <u>61</u> |
| <u>sand & gravel</u> | <u>61</u> | <u>110</u> |

Broverness, MS.
(mailing address)

WELL LOCATION:

sec. 11 T. 170 N. R. 4 E. (W)
1 miles SE of Broverness
(distance) (direction) (nearest town)

WELL PURPOSE:
(home, irrigation, municipal, industrial)

CODED


WELL COMPLETION DATA:

- (1) diameter (inches) 16"
- (2) total depth (feet) 110'
- (3) static water level (feet) 22' below above top of ground.
- (4) casing Steel, 70',
(material) (depth)
16" if telescope see back.
(size)
- (5) screen 40', 70'
(length) (depth to top)
16", Steel
(size) (material)
- (6) pump 60 1000
(HP) (yield gpm)
Diesel
(type power)
- (7) electric log no
(yes or no)

(organization running log)

(8) how well bottom plugged plate

DRILLERS REMARKS:

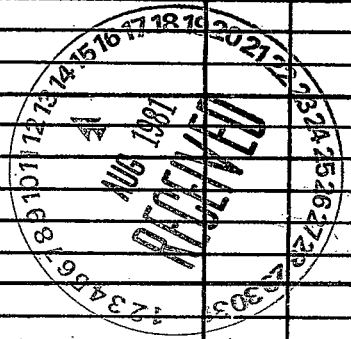

If well telescopes please sketch and show depths.

GROUND LEVEL

| | | | |
|--|---|--|--|
| | γ | | |
| | | | |
| | | | |
| | | | |

SECTION 11

Please indicate well location X.

ADDITIONAL INFORMATION

If more than one screen,
show locations of each on sketch.