

MISSISSIPPI DEPARTMENT OF NATURAL RESOURCES

Bureau of Land and Water Resources

Southport Mall

P.O. Box 10631

Jackson, Mississippi 39209

WATER WELL DRILLERS LOG

CODED

SUNFLOWER
T 60
7-25-81

7/25/81
date well completed

Superwell & Surg
firm name

Sunflower
county well located

LANDOWNER: J.B. Reed

description of formations encountered

from

to

Business, MS
(mailing address)

Clay	0	48'
Sand	48	78
Fine Sand	78	87
Sand + Gravel	87	126

WELL LOCATION:

sec. 2 T 17 N S R 4 E W
1 miles E of Business
(distance) (direction) (nearest town)

WELL PURPOSE:

(home, irrigation, municipal, industrial)

WELL COMPLETION DATA:


- (1) diameter (inches) 16
- (2) total depth (feet) 126
- (3) static water level (feet) 20 below above top of ground.
- (4) casing Steel, 86'
(material) (depth)
16" if telescope see back.
(size)
- (5) screen 40', 86'
(length) (depth to top)
16, Steel
(size) (material)
- (6) pump 60 1200
(HP) (yield gpm)
Diesel
(type power)
- (7) electric log No
(yes or no)

(organization running log)

- (8) how well bottom plugged Plate


DRILLERS REMARKS:

CODED

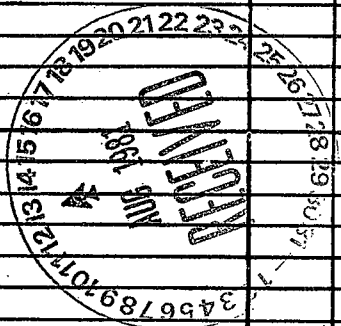

If well telescopes please sketch and show depths.

GROUND LEVEL

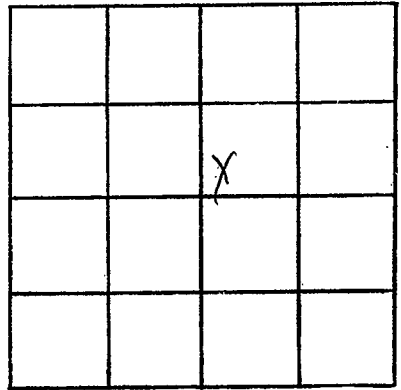

SECTION 2

Please indicate well location X.

ADDITIONAL INFORMATION

If more than one screen,
show locations of each on sketch.