

MISSISSIPPI DEPARTMENT OF NATURAL RESOURCES

Bureau of Land and Water Resources

Southport Mall

P.O. Box 10631

Jackson, Mississippi 39209

WATER WELL DRILLERS LOG

CODED

Sun Flower
T61
L-18-81

June 18, 1981 Larry's Well Pump Sunflower
 date well completed firm name county well located

LANDOWNER: Ramey Tinnin	description of formations encountered	from	to
Caile MS. (mailing address)			
	CLAY	0	40
	FINE & MEDIUM SAND	40	60
	MED & COARSE SAND	60	100

WELL LOCATION:
 sec. 22 T 17 N R 4 W
 5 miles S of ~~Freeport~~

WELL PURPOSE: Fish Pond
 (home, irrigation, municipal, industrial)

WELL COMPLETION DATA:

(1) diameter (inches) 8"

(2) total depth (feet) 100'

(3) static water level (feet) 2.4 below top of ground.

(4) casing Plastic, 60' (material), (depth), 8" (size) if telescope see back.

(5) screen 40' (length), 60' (depth to top), 8" (size), Plastic (material)

(6) pump 10 (HP), 700 (yield gpm)

(type power)

(7) electric log No (yes or no)

(organization running log)

(8) how well bottom plugged PVC cap

CODED

DEPT. OF NATURAL RESOURCES
 BUREAU OF LAND & WATER RESOURCES


OCT 15 1981

RECEIVED

DRILLERS REMARKS:

If well telescopes please sketch and show depths.

GROUND LEVEL

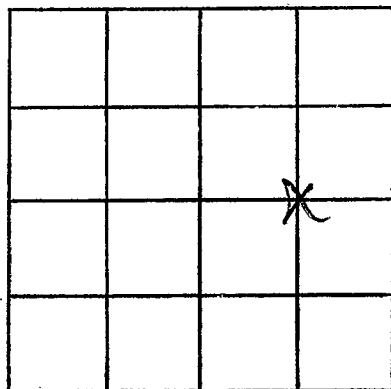

SECTION 22

Please indicate well location X.

ADDITIONAL INFORMATION

If more than one screen, show locations of each on sketch.