

MISSISSIPPI DEPARTMENT OF NATURAL RESOURCES

Bureau of Land and Water Resources

Southport Mall

P.O. Box 10631

CODED

Jackson, Mississippi 39209

WATER WELL DRILLERS LOG

Sunflower
T 6.2
1/25/82

1-25-82 19 Aug Well & Irrigation Sunflower
 date well completed firm name county well located

LANDOWNER: Pointe Vista
 (mailing address)
 WELL LOCATION:
 sec. 5 T 17 S R 4 E
2 miles W of Immerson
 (distance) (direction) (nearest town)

WELL PURPOSE:
 (home, irrigation, municipal, industrial)

WELL COMPLETION DATA:

- (1) diameter (inches) 16"
- (2) total depth (feet) 133
- (3) static water level (feet) _____ below
 top of ground. above
- (4) casing Steel, 83
 (material) (depth)
16" if telescope see back.
 (size)
- (5) screen 40'
 (length) (depth to top)
16", med Steel
 (size) (material)
- (6) pump 40 2000
 (HP) (yield gpm)
diesel
 (type power)
- (7) electric log NO
 (yes or no)
- (organization running log) _____
- (8) how well bottom plugged Plate

description of formations encountered	from	to
<u>Clay</u>	<u>0</u>	<u>13</u>
<u>Clay</u>	<u>13</u>	<u>23</u>
<u>Clay</u>	<u>23</u>	<u>33</u>
<u>Clay</u>	<u>33</u>	<u>43</u>
<u>Clay</u>	<u>43</u>	<u>53</u>
<u>Clay</u>	<u>53</u>	<u>63</u>
<u>Clay</u>	<u>63</u>	<u>73</u>
<u>Clay</u>	<u>73</u>	<u>83</u>
<u>G Sand</u>	<u>83</u>	<u>93</u>
<u>Sand & Gravel</u>	<u>93</u>	<u>103</u>
<u>Sand & Gravel</u>	<u>103</u>	<u>113</u>
<u>Sand & Gravel</u>	<u>113</u>	<u>123</u>
<u>Sand & Gravel</u>	<u>123</u>	<u>133</u>

DEPT. OF NATURAL RESOURCES
 BUREAU OF LAND & WATER RESOURCES


JUN 30 1982

RECEIVED

DRILLERS REMARKS:

If well telescopes please sketch and show depths.

GROUND LEVEL

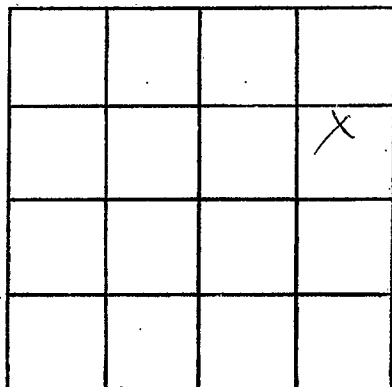

SECTION 5

Please indicate well location X.

ADDITIONAL INFORMATION

If more than one screen, show locations of each on sketch.