

MISSISSIPPI DEPARTMENT OF NATURAL RESOURCES
Bureau of Land and Water Resources

Southport Mall
P.O. Box 10631

CODED

Jackson, Mississippi 39209
WATER WELL DRILLERS LOG

Sunflower
~~ST-2156~~
T 63
5/28/82

5-28 1982 Layne-Central Co. Sunflower
date well completed firm name county well located


LANDOWNER:	description of formations encountered	from	to
<u>Bill Lester</u>			
<u>Inverness, Ms</u> (mailing address)	<u>brown sand</u>	<u>11</u>	<u>25</u>
WELL LOCATION:	<u>coarse sand & pea gravel</u>	<u>25</u>	<u>53</u>
sec. <u>14</u> T. <u>17</u> (N) R. <u>4</u> E	<u>fine sand</u>	<u>53</u>	<u>59</u>
<u>2</u> miles <u>S</u> of <u>Inverness</u>	<u>coarse sand</u>	<u>59</u>	<u>68</u>
(distance) (direction) (nearest town)	<u>coarse sand & gravel</u>	<u>68</u>	<u>85</u>
WELL PURPOSE: (home, irrigation, municipal, industrial)	<u>coarse sand</u>	<u>85</u>	<u>96</u>
WELL COMPLETION DATA:	<u>coarse sand & gravel</u>	<u>96</u>	<u>122</u>
(1) diameter (inches) <u>32"</u>			
(2) total depth (feet) <u>122'</u>			
(3) static water level (feet) <u>24'</u> below top of ground.			
(4) casing <u>steel</u> <u>72'</u> (material) (depth)			
<u>16"</u> (size) if telescope see back.			
(5) screen <u>50'</u> <u>72'</u> (length) (depth to top)			
<u>16"</u> <u>stainless steel</u> (size) (material)			
(6) pump <u>60</u> <u>200</u> (HP) (yield gpm)			
<u>gear drive</u> (type power)			
(7) electric log <u>No</u> (yes or no)			
(organization running log)			
(8) how well bottom plugged <u>Steel Plate</u>			
DRILLERS REMARKS:			

DEPT. OF NATURAL RESOURCES
BUREAU OF LAND & WATER RESOURCES

DEC - 6 1982
RECEIVED

If well telescopes please sketch and show depths.

GROUND LEVEL

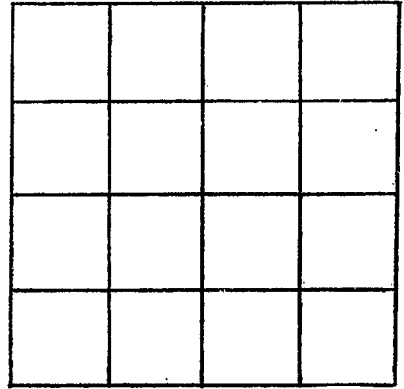

SECTION _____

Please indicate well location X.

ADDITIONAL INFORMATION

If more than one screen,
show locations of each on sketch