

SUNFLOWER
T 65

MISSISSIPPI DEPARTMENT OF NATURAL RESOURCES
Bureau of Land and Water Resources
Southport Mall
P.O. Box 10631
Jackson, Mississippi 39209
WATER WELL DRILLERS LOG

CODED

March 09, 1984
date well completed

Lewis Well Pump
firm name
Sunflower
county well located

LANDOWNER: Robert Poindexter
Lawrence Mo.
(mailing address)

description of formations encountered	from	to
shale	0	30
sand	30	60
coarse sand gravel	60	116

WELL LOCATION:
sec. 4 T 17 N R 4 E
S W 4 W
1 miles W of Lawrence
(distance) (direction) (nearest town)

CODED

WELL PURPOSE:
(home, irrigation, municipal, industrial)

WELL COMPLETION DATA:

- (1) diameter (inches) 12"
- (2) total depth (feet) 116'
- (3) static water level (feet) 22 ^{below} ~~above~~ top of ground.
- (4) casing Steel 76'
(material) (depth)
(size) If telescope see back.
- (5) screen 40' 76'
(length) (depth to top)
12" Steel
(size) (material)
- (6) pump 40 2500
(HP) (yield gpm)
0
(type power)
- (7) electric log No
(yes or no)
(organization running log)
- (8) how well bottom plugged Steel
Plate

DEPT. OF NATURAL RESOURCES
BUREAU OF LAND & WATER RESOURCES


AUG 23 1984

RECEIVED

DRILLERS REMARKS:

If well telescopes please sketch and show depths.

GROUND LEVEL

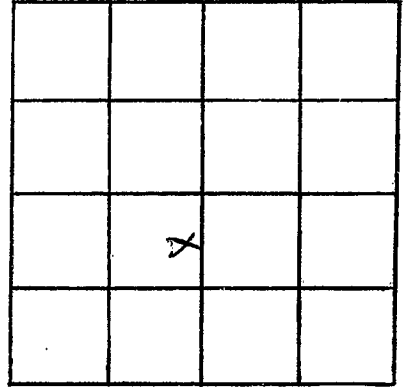

SECTION 4

Please indicate well location X.

ADDITIONAL INFORMATION

If more than one screen, show locations of each on sketch.