

MISSISSIPPI DEPARTMENT OF NATURAL RESOURCES

Bureau of Land and Water Resources

Southport Mall

P.O. Box 10631

Jackson, Mississippi 39209

WATER WELL DRILLERS LOG

CODED

SUNFLOWER

T 66

7-30-84

date well completed

19

IRRIGATION EQUIPMENT

firm name

Sunflower

county well located

LANDOWNER: Edward Cobb

Rt. 1 Box 96

ISOLA, MS 38754

(mailing address)

description of formations encountered

from

to

Clay	0	25
SAND	25	65
SAND AND GRAVEL	65	115

WELL LOCATION:

sec. 34 T. 17 N. R. 4 E.
 5 miles South of INVERNESS
 (distance) (direction) (nearest town)

WELL PURPOSE: IRRIGATION
 (home, irrigation, municipal, industrial)

WELL COMPLETION DATA:

- (1) diameter (inches) 10"
- (2) total depth (feet) 115'
- (3) static water level (feet) 22' below top of ground.
- (4) casing PVC 75' (material) (depth)
- (size) if telescope see back.
- (5) screen 40' 75' (length) (depth to top)
- 10" PVC (size) (material)
- (6) pump 10' 650 (HP) (yield gpm)
- Elec. (type power)
- (7) electric log (yes or no)

(organization running log) PVC CAP

(8) how well bottom plugged

DRILLERS REMARKS:

CODED


DEPT. OF NATURAL RESOURCES
 BUREAU OF LAND & WATER RESOURCES

SEP 26 1984

RECEIVED

If well telescopes please sketch and show depths.

GROUND LEVEL

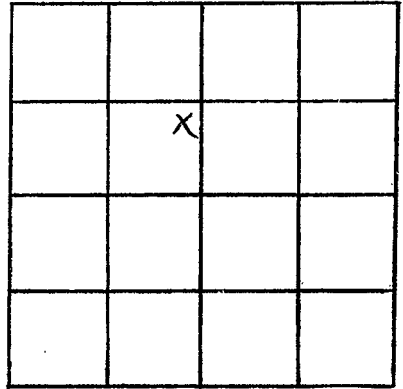

SECTION 34

Please indicate well location X.

ADDITIONAL INFORMATION

If more than one screen, show locations of each on sketch.